


State of South Carolina

Pursuant to a warrant from John Thomas Esq^r Commissioner of Locations dated the 21 day of May 1781, I have admeasured and laid out unto James Jordan Esq^r, a Tract of Land situate in Ninety Six district on the Branches of Needy River N.W. of the ancient Boundary line Bounding S.E. on Land laid out to Charles Littleton and on all other sides by Vacant Land containing Three Hundred acres and hath such Shape and Marks as the above plat Represents,

Surveyed the 10th day of June 1781.

Delivered to Samuel Earle W^m Benson Esq^r

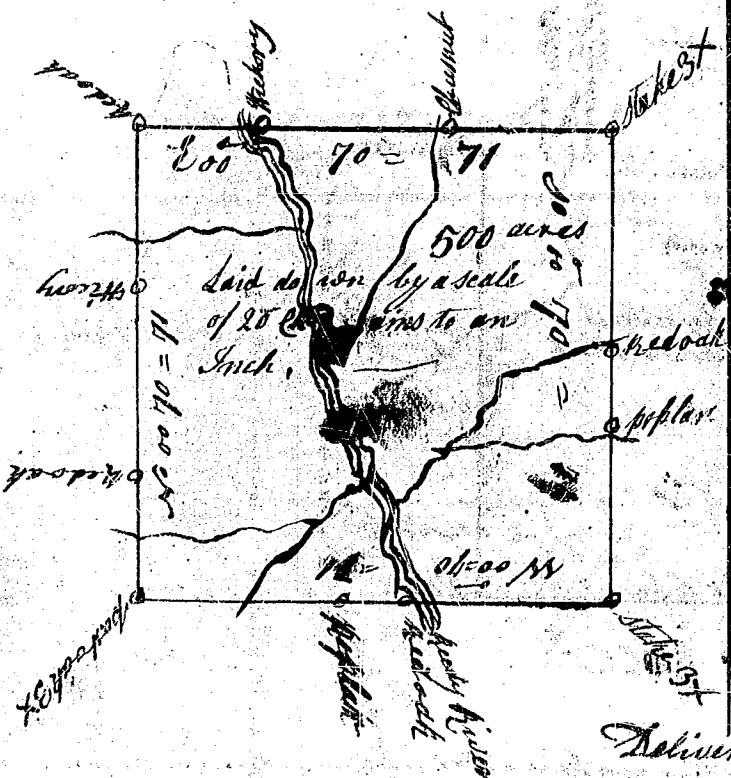


State of South Carolina

Pursuant to a warrant from John Thomas Esq^r Commissioner of Locations dated the 21 day of May 1781, I have admeasured and laid out unto William Prince a Tract of Land situate in Ninety Six district on the waters of Needy River to N.W. of the ancient Boundary, containing Five Hundred acres bounding on all sides by Vacant Land, and hath such Shape and Marks as the above plat Represents.

Surveyed the 9th day June 1781

W^m Benson Esq^r

Delivered to Samuel Earle

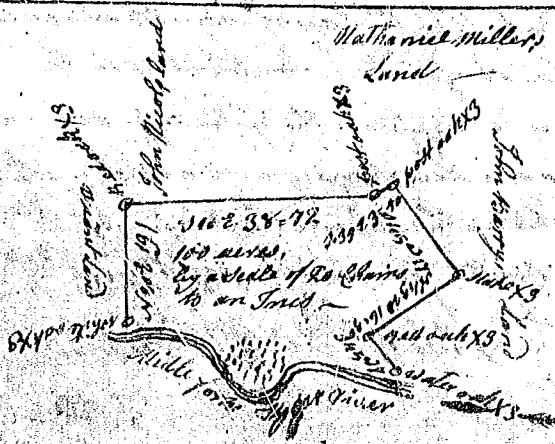

State of South Carolina

Pursuant to a warrant Directed unto the hand and seal of John Benson Esq^r Deputy Surveyor general dated the 17th day of January 1781, I have admeasured and laid out unto Ann M^r Cross of plantation or tract of land containing one hundred acres in Craven County, Situate lying and being on the south side of the middle fork of Tyger River, and bounded southwardly by said river, and bound eastwardly by John Miller's land and bound southwardly by Nathaniel Miller and John Barry's land, and bound on all other sides by Vacant Land and hath such shape form and mark as the above plat Represents,

Certified under my hand for the 10th day of June
1781,

James Wofford Esq^r

affidavit being made in my office appearable it is on an act of assembly passed 21 March 1781, by John & R. S.