


Pursuant to a warrant from John Thomas Esq<sup>r</sup> Commissioner of Locations dated the 25<sup>th</sup> day of May 1784, I have admeasured and laid out unto Maj. John Gord a tract of four hundred acres land situate in Ninety six district on the North fork Saluda River Bounding to the S. E. by lands laid out to John Clayton and on all other sides by Vacant lands and hath such shape and marks as the above plat doth presents.

Surveyed the 9<sup>th</sup> day of May 1784

W<sup>m</sup> Benson A.D.


Recorded the 2<sup>d</sup> July 1784

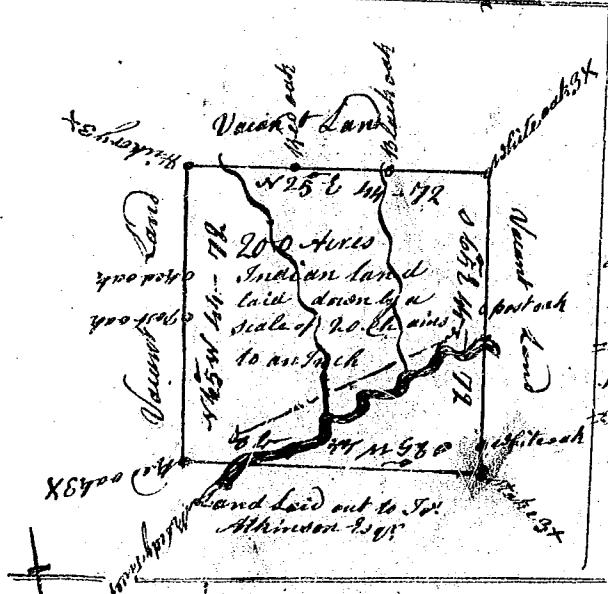

Pursuant to a warrant from John Thomas Esq<sup>r</sup> Commissioner of Locations dated the 25<sup>th</sup> day of May 1784 I have admeasured and laid out unto John Gord a tract of two hundred acres land situate lying and being in Ninety six district on Needy Hill Bounding to the S. E. by lands laid out to Joseph Atkinson Esq<sup>r</sup> and on all other sides by Vacant land, and hath such form and marks as the above plat doth represent.

Surveyed the 11<sup>th</sup> day of June

1784 W<sup>m</sup> Benson A.D.

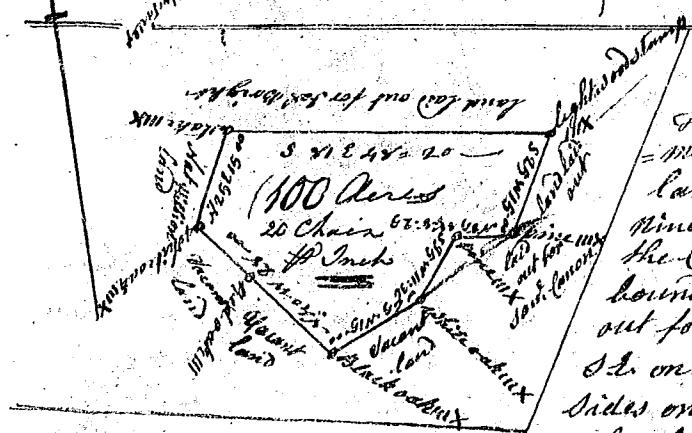

Pursuant to a warrant from John Thomas Esq<sup>r</sup> Commissioner of Locations, I have admeasured and laid out unto Baron Lucy a tract of land containing one hundred acres situate in Ninety six district below the Indian Boundary near the Cedar Shale Creek a branch of Saluda River bounding S. W. on lands laid out N. E. on lands laid out for Samuel Cannon N. E. & Nathaniel Willcocks S. E. on lands laid out for James Bright and on all other sides on Vacant land, and hath such shape and marks as the above plat doth represent.

Surveyed this 9<sup>th</sup> day of June 1784

Recorded the 2<sup>d</sup> day July 1784

Robert Hume A.D.