


State of South Carolina

115

Pursuant to a warrant from John Thomas Esq<sup>r</sup> Commissioner of Locations I dated the 21 day of May 1784 I have admeasured and laid out unto William Lynch a tract of eighty nine acres of land situate in Ninety six District on sink hole fork of Biggar River Bounding N.E. on land laid out to Mr Davis and W on land laid out to Edmund Read and on all other sides on Vacant land


and hath such shape and marks as the above Plat Represents, MURKIN Sh. 2d June 1784  
Recorded the 31 day of August 1784 Del<sup>d</sup> to Capt Gowin 125<sup>th</sup> Benson D.

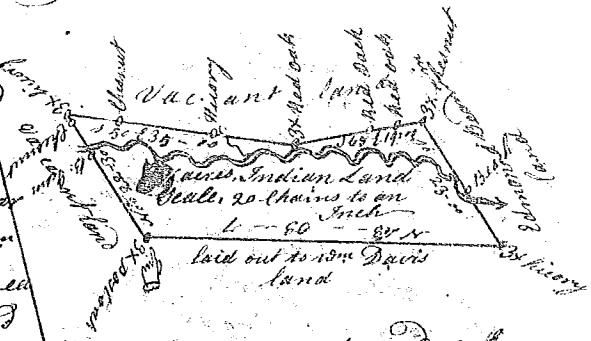

State of South Carolina

Pursuant to a warrant from John Thomas Esq<sup>r</sup> Commissioner of Locations 21 day May 1784 I have admeasured and laid out unto John Palmer a tract of two hundred and forty four acres of land situate in Ninety six District on the branches of Melchor's Creek Bounding on all sides on Vacant Land and hath such Shape and Marks as the above annexed plat Represents, MURKIN 23 July 1784 J. H. Benson D.

Recorded 31 day August 1784

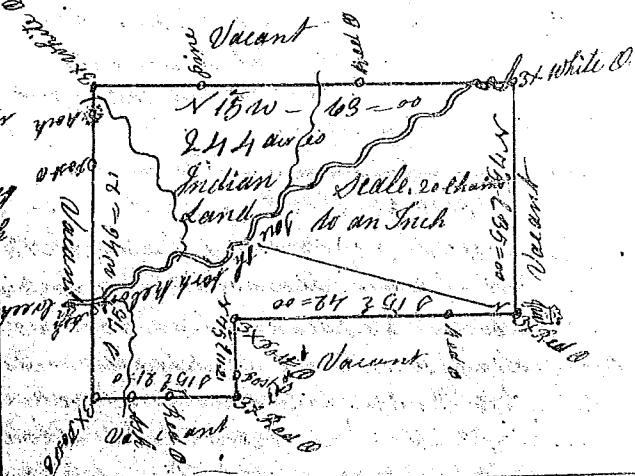

State of South Carolina 96 Dist

Pursuant to a warrant to me Directed by John Thomas Esq<sup>r</sup> Commissioner of locations for the district of the North Side of Saluda River I have surveyed and laid out unto Frances Hale a tract of Land containing 500 acres situate lying and being below the ancient Boundary line on both sides of Peters Creek of Saluda River Vacant lands on all sides and hath such shape and marks as the annexed Plat Represents Surveyed 23 Aug 1784

James Seaborn D.

Recorded the 31 day Augt 1784



State of South Carolina

Pursuant to Warrant from John Thomas Esq<sup>r</sup> Commissioner of Locations No. 21 day of May 1784 I have admeasured and laid out unto Caleb Stone a tract of land containing fifty acres on Clear Shot Creek a branch of Enore River Below the Indian Boundary Bounded S. E. & W. on John Stoner's land and all other sides on Vacant Land and hath such shape and marks as the annexed Plat Represents Surveyed the 2d June 1784

Recorded the 1st Sept 1784

Rob. Hannard

