

State of S. Carolina qd District

(137)


On the East side of the ancient Boundary Line Pensacola to a warrant from John Thomas Esq^r Commissioner of Locations dated the 1st June

1784 I have admeasured and laid out unto Ephraim Hill a tract of land containing two hundred and fifty seven acres lying on a small spring branch of Dute Williams Creek bounded to the North by Samuel Morris land to the west by an old Survey all other sides by Vacant Land and hath such shape and marks as the above plat represents. Surveyed the

3rd of August 1784

Andrew Thompson D.S.

Recorded the 27th Augt 1784

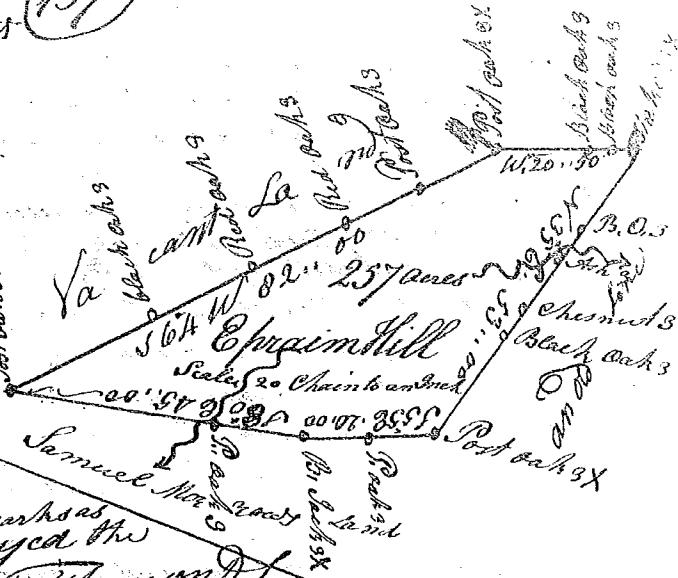


State of South Carolina Ninety six district East off the Indian Boundary line

Pursuant to a warrant from John Thomas Esq^r Commissioner of Location on the North side of Saluda River dated the 17th July 1784 I have admeasured and laid out unto William Thomson a tract of land containing two hundred and forty seven acres lying on a small branch of Shickley Creek bounded to the SW by one Morris land NW by the said William Thomson's land, all other sides Vacant Land and hath such shape and Marks as the above plat represents.

Surveyed the 1st day July 1784

Andrew Thomson D.S.

Recorded 27th Sept 1784

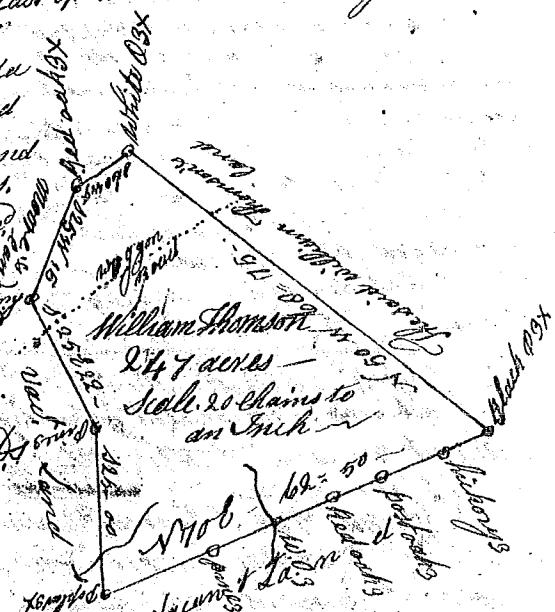

State of South Carolina qd District

Pursuant to a warrant to me directed by John Thomas Esq^r Commissioner of Locations for the district of the North side of Saluda River I have surveyed and laid out unto Isaac Chapman a tract of land containing

two hundred and fifty acres situate lying and being below the ancient boundary line on the south side of Broad River beginning at the mouth of people's Creek about 4 rods below the Cherookee ford thereon by the name of Malawee Improvement, Bounded NE on Broad River on all other sides by Vacant Land and hath such shape and Marks as the above plat represents Surveyed 29th Sept 1784 J. Saborni D.S.

Recorded 27th Sept 1784

