


(168)

State of South Carolina qd District  
East of the ancient Boundary Line

Pursuant to a warrant from John Thomas Esq<sup>r</sup> Commissioner of location dated the 15th July 1784 I have admeasured and laid out unto Aaron Jackson a tract of Land containing two hundred acres lying on a small branch of fairforest Creek bounded W. by armstrong's land S. by Edward Denry land & all other sides vacant, and hath such shape and marks as the annexed Plat represents.

Surveyed the 10th July 1784 Phil<sup>r</sup> Waters D.S.  
Recorded the 28 Sept<sup>r</sup> 1784

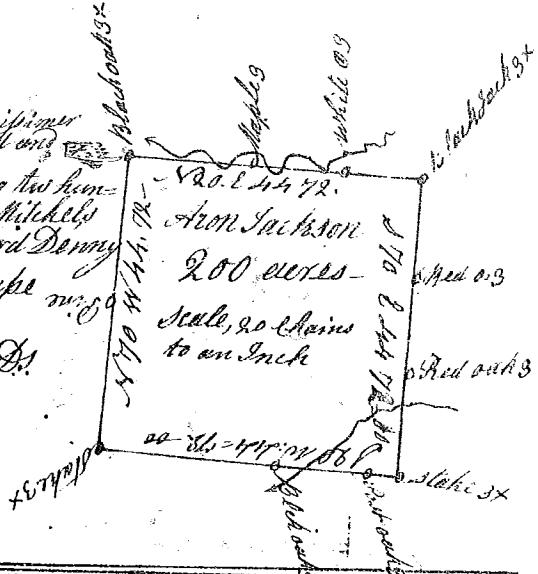

State of South Carolina Ninety six district East of the boundary line

Pursuant to a warrant from John Thomas Esq<sup>r</sup> Commissioner of Locations North side

of Saluda dated 19th June 1784 I have

admeasured and laid out unto Thomas

Blosengame a tract of Land contain-

ing one hundred and eleven acres

lying on sugar creek, bounded N. by

James Bettont's land S. E. by ant-

line other two sides by the said

Blosengame's land and hath such

shape and Marks as the annexed Plat

Represents, Surveyed 11th Aug<sup>r</sup> 1784

Phil<sup>r</sup> Waters D.S.

Recorded 28 Sept<sup>r</sup> 1784

State of South Carolina Ninety Six District East  
of the ancient boundary line

Pursuant to a warrant from John Thomas

Esq<sup>r</sup> Commissioner of locations to the north

Side Saluda River; dated the 3<sup>r</sup> June 1784 I have

admeasured and laid out unto John Blalock a tract

of Land containing two hundred acres lying on thick-

creek bounded S. E. by william Thompson's all


other sides vacant land and hath such shape and

Marks as the annexed Plat represents

Surveyed 20 July 1784

Phil<sup>r</sup> Waters D.S.

Recorded 28 Sept<sup>r</sup> 1784,

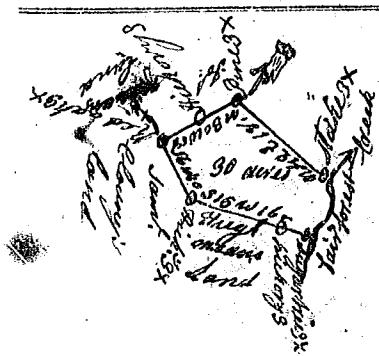

State of South Carolina qd District East of the ancient Boundary Line

Pursuant to a warrant from John

Thomas Esq<sup>r</sup> Commissioner of locations

dated 15th July 1784 I have admeasured

and laid out unto Joseph Meares a tract of

Land containing thirty acres lying on the north side

of fairforest Creek bounded S. by said Creek to the E. by

said Joseph Meares's land N. by Samuel Cloney's land to the

W. by Hugh Meares's land, and hath such shape and Marks

as the above Plat represents Surveyed 11th Aug<sup>r</sup> 1784

Phil<sup>r</sup> Waters D.S.