


State of South Carolina

Pursuant to warrant from John Thomas Esq^r Commissioner of Locations in No^o District No Saluda River, dated 20th day of July 1784 I have admeasured and laid out unto Jane M^r Glorkin abstract of land containing one hundred acres on Sammey's Creek in Ninety Six District Below the Indian boundary Bounding west and so on land laid out to David Dinsonmore N^r & on surveyed land all other sides on Vacant land, and hath shape and Marks as the annexed Plat Represents, At W^r W^r the 15 July 1784
Recorded 6th Nov^r 1784, — Robt. Hanna D^r

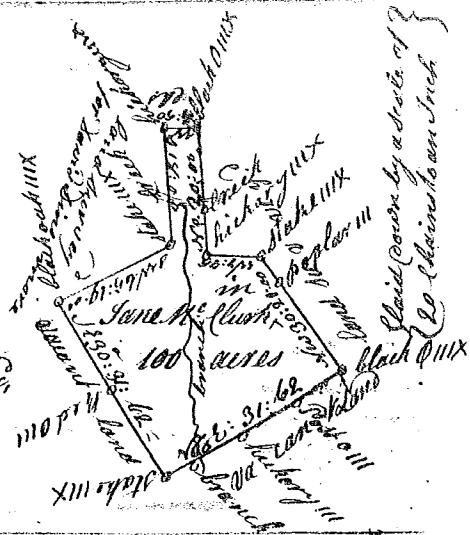


State of South Carolina

Pursuant to warrant from John Thomas Esq^r Commissioner of Locations in Ninety Six District No^o Saluda River, dated 28th June 1784 I have admeasured and laid out unto David George Esq^r a tract of land containing one hundred acres on Duncan's Creek below the Indian boundary, bounded on land laid out for Samuel Aubrey, Non land laid out for Robert Hanna, all other sides on Vacant land, and hath such shape and Marks as the annexed Plat Represents, At W^r W^r the 12th day of June 1784. Robt. Hanna D^r
Recorded 8th Nov^r 1784.



State of South Carolina

Pursuant to warrant from John Thomas Esq^r Commissioner of Locations in Ninety Six District No^o Saluda River dated 17th day of July 1784, I have admeasured and laid out unto Richard Sirian abstract of land containing three hundred acres on a branch of Duncan's Creek below the Indian boundary, Bounded on all sides on Vacant land, and hath such shape and Marks as the annexed Plat Represents, Surveyed the 26th day of July 1784.
Recorded 8th Nov^r 1784, — Robt. Hanna D^r

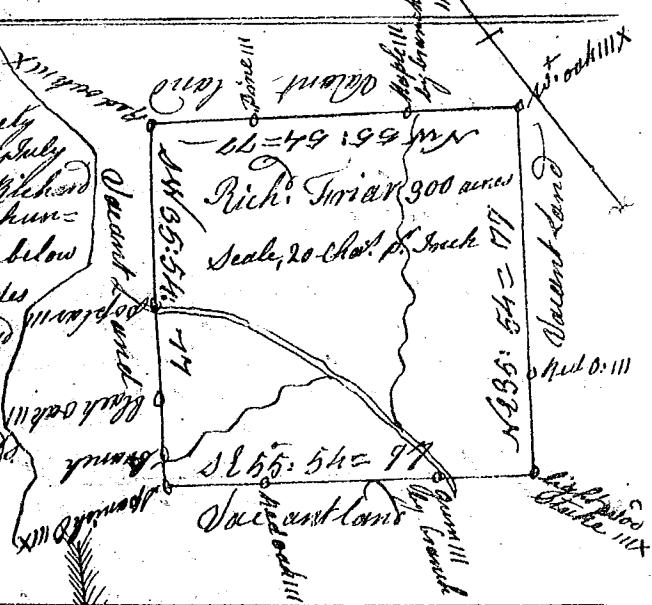

State of South Carolina,

Pursuant to a warrant from John Thomas Esq^r Commissioner of Locations in Ninety Six District No^o Saluda River dated the 20th day of July 1784 I have admeasured and laid out unto Robert Long abstract of land containing one hundred and ninety four acres on Allison's Creek below the Indian boundary, bounded on land laid out for Josiah Green, all other sides on Vacant land, claimed by John Hamage and John Houston, and hath such shape and Marks as the above Plat Represents, Surveyed 25th Sept^r 1784, — Robt. Hanna D^r
Recorded 8th Nov^r 1784,

