



State of South Carolina



State of South Carolina Pursuant to a warrant from John Thomas Esq. Commissioner of Locations in 96 District No Saluda River I have measured and laid out unto Thomas

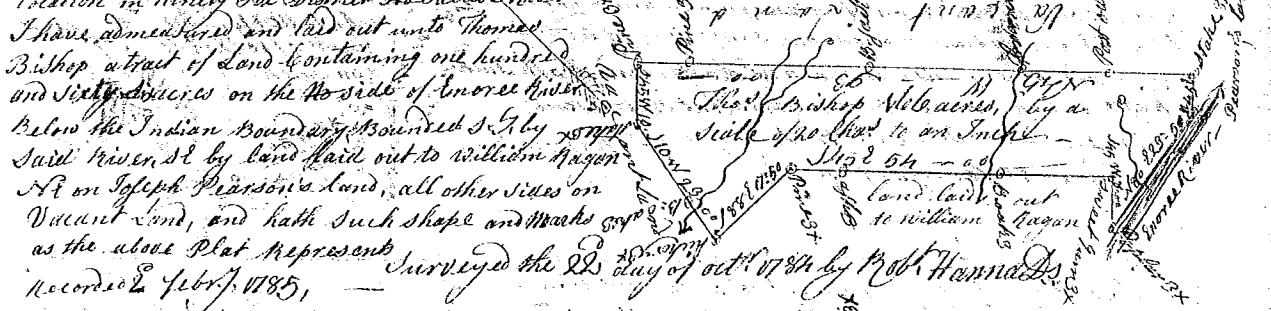

State of South Carolina Pursuant to a warrant

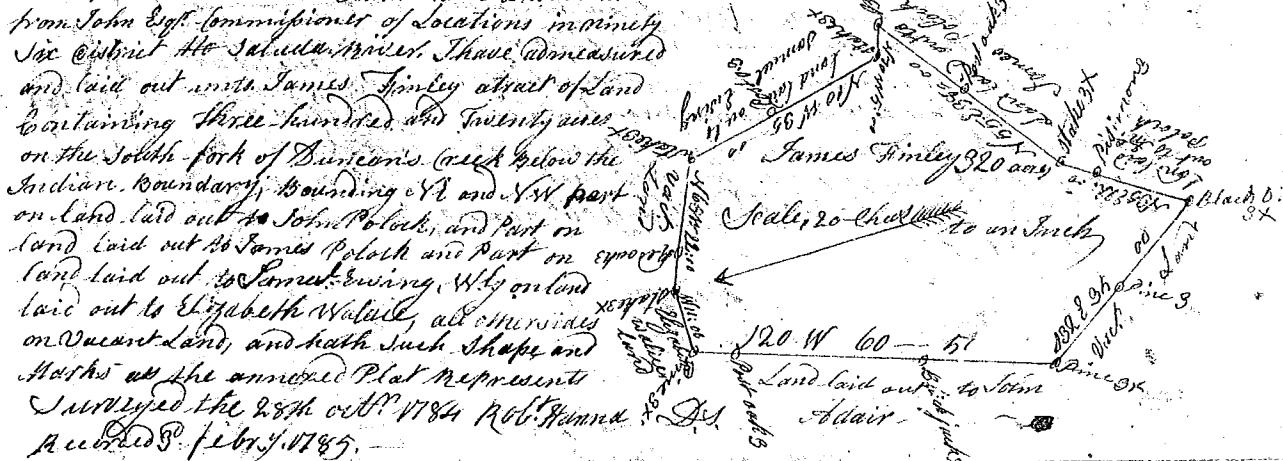

State of S. Carolina Pursuant to a warrant from John Thomas Esq. Com. Locations in 96



State of S. Carolina Pursuant to a warrant from John Thomas Esq. Com. Locations in 96 District No Saluda River I have measured and laid out unto Adam Gordon a tract of 300 acres of land on a branch of Duncan's Creek below the Indian Boundary Bounding N W on land laid out to Philmon Harry & S W on land laid out to John Cunningham all other sides Vacant & hath such shape and marks as the annexed Plat represents Surveyed the 13<sup>th</sup> Oct 1784 Robert Hanna As.

Recorded the 3<sup>rd</sup> February 1785 Delivered to John Hanna