

State of South Carolina) P

79

Pursuant to a Warrant
from John Thomas Esq^r, Commissioner of Locations, dated
the 19th day of March 1785. I have admeasured & laid out
Unto Wilson Rodgers a Tract of Two Hundred & forty three
Acre of Land, Situate in Ninety Six District East of the
Old Boundary, on both sides of a branch of Thicketty Creek
Waters of Broad River & hath such form marks Buttling's &
Boundings, as the annex^d plat Represents.

Surveyed the 25th March 1785.

Certified George Salmon Esq^r

Recorded the 29th March 1785 Deliv^r to Wilson Rodgers




State of South Carolina) P^r Pursuant to a warrant from

John Thomas Esq^r, Commissioner of Locations, dated the
31st day of Dec^r 1784. I have admeasured and laid out
Unto Michael Walling a Tract of one hundred and Twenty
Two acre of Land Situate in qd District West of the ancient
Boundary, on Elisha Thompsons Beavendam creek of Middle Tygar
River, Bounding to the Wth on land laid out to Joseph McEoal
all Other sides Vacant & hath such shape marks as the annex^d
plat Represents, Survey'd this 6th of Jan^r 1785

Wm. BENSON Esq^r

Recorded the 29th day of March 1785

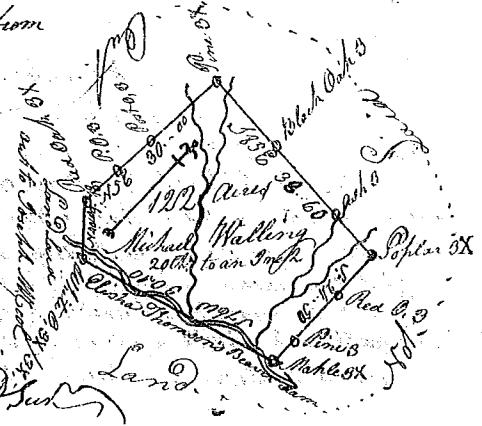


State of South Carolina) Pursuant to a

Warrant from John Thomas Esq^r, Commissioner of Locations, dated the 19th day of Jan^r 1785. I

Have admeasured & laid out unto Martin
Armstrong a Tract of Three hundred and
Seventy Seven acres of Land Situate in
qd District on the Branches of Tygar River
East of the old Boundary Line hath
such form marks Buttling's, Boundings,
as the annex^d plat Represents
Survey'd the 15th March 1785 G^r Salmon Esq^r

Recorded the 29th March 1785

Deliv^r to Geo. Salmon D^r

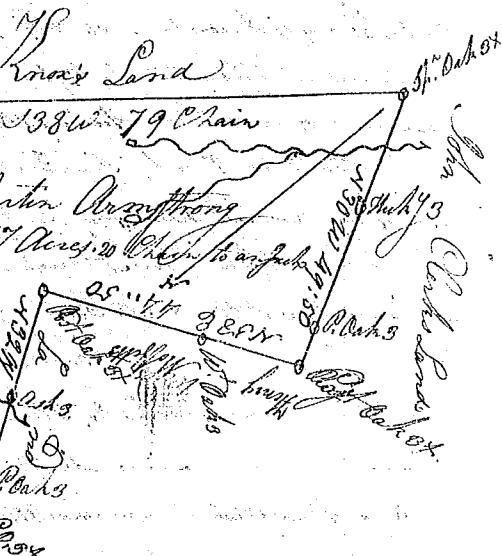

State of South Carolina) Pursuant to a Warrant

from John Thomas Esq^r, Commissioner of Locations, dated
the 9th day of February 1785. I have admeasured land

Laid out unto George Thompson a Tract of one hundred and
Eighty Three acre of Land Situate in qd District
East of the old Boundary line on both sides of South Peech
River, & hath such shape marks Buttling's & Boundings
as the annex^d plat Represents

Survey'd the 11th of Feb^r 1785 J. D. THOMSON Esq^r

Recorded the 30th March 1785 Del. John Clayton

