



State of South Carolina / 96  
 Pursuant to a warrant from John Thomas Esq<sup>r</sup> Commissioner of Locations  
 dated the 3<sup>d</sup> day of February 1785, I have admeasured and laid out unto  
 John Campbell abstract of land containing twenty nine acres situate  
 in Ninety six District East of the ancient Boundary on John Leake's wagon  
 Road, Bounding to the S<sup>E</sup> on Land granted to Joseph Thomson N.E. by S.W.  
 Joseph Jones, and on Vacant Land; hath such Shape and Marks as  
 The above Plat Represents, Survey'd the 29<sup>th</sup> March 1785,  
 Recorded the 21<sup>st</sup> day of April 1785. — W<sup>m</sup> Benson D<sup>s</sup>

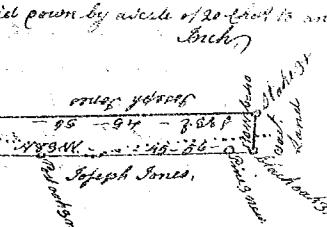

State of South Carolina,


Pursuant to a warrant from John Thomas Esq<sup>r</sup> Commissioner of  
 Locations for Ninety six District N<sup>E</sup> Saluda River dated the 3<sup>rd</sup> dec<sup>r</sup> 1784, I have  
 admeasured and laid out unto Hugh Gray abstract of Sixty acres of Land situate  
 in Ninety Six District on the N<sup>E</sup> side of Saluda River, Below the ancient  
 Boundary, Bounded on the South by Saluda River E<sup>S</sup> by Horry  
 Medditer Land N<sup>E</sup> by John Glenn's Land on the N<sup>W</sup> by the Wilson Turners  
 Land, hath such shape and Marks as the above Plat Represents.

Survey'd the 2<sup>d</sup> feby 1785 Phil<sup>m</sup> Waters D<sup>s</sup>  
 Recorded 21<sup>st</sup> day of April 1785,

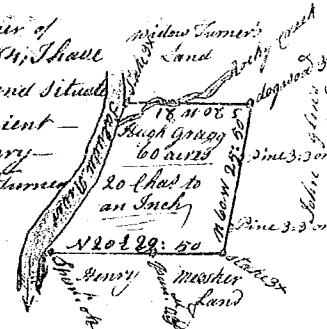

State of S<sup>t</sup> Carolina / Pursuant to a warrant  
 from John Thomas Esq<sup>r</sup> Commissioner of Locations

for Ninety Six District N<sup>E</sup> Saluda River, dated  
 the 2<sup>d</sup> day of Jan<sup>r</sup> 1785, I have admeasured and  
 laid out unto James Buchanan abstract of two  
 hundred acres of Land, situate in Ninety Six Dist<sup>r</sup>  
 lying on the south side of Broad River, below the  
 ancient boundary line, bounded towards the N<sup>E</sup> by  
 broad River on the N<sup>W</sup> by Jacob Oxenner's Land &  
 by Liles's Land SW by Land Survey'd for James Buchanan  
 and hath such shape and Marks as the above Plat  
 Represents, Survey'd the 21<sup>st</sup> feby 1785 Phil<sup>m</sup> Waters D<sup>s</sup>  
 Recorded 22<sup>nd</sup> April 1785,

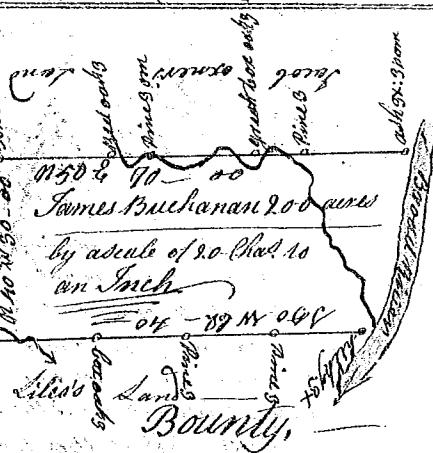

State of South Carolina /

Pursuant to a warrant from John Thomas Esq<sup>r</sup> post<sup>d</sup> East of the ancient Boundary line  
 Commissioner of Locations, dated the 2<sup>d</sup> July 1785,  
 I have admeasured and laid out unto George Newman  
 abstract of Land containing Two hundred and Twenty  
 four acres, lying on the North side of Tugger River  
 and on the small branches of Dutchman's Creek  
 bounded NE on Ralph Smith's Esq<sup>r</sup> land S<sup>E</sup> by John  
 Beardon's land, all other sides Vacant Land,  
 and hath such shape and Marks as the  
 above Plat Represents, Survey'd 1<sup>st</sup> feby 1785.

Recorded 28<sup>th</sup> April 1785, — Andrew Thompson  
 Del<sup>r</sup> Mr<sup>r</sup> God<sup>r</sup> D<sup>s</sup>



State of South Carolina /

Pursuant to a warrant from John Thomas Esq<sup>r</sup> Commissioner  
 of locations for Ninety Six District N<sup>E</sup> side Saluda River, dated the  
 19<sup>th</sup> Nov<sup>r</sup> 1784, I have admeasured and laid out unto James Gray  
 abstract of one hundred acres of Land, situate in Ninety Six District  
 on the North side of Saluda River, below the ancient boundary  
 line, on waters of Bush River, bounded on the N<sup>E</sup> & S<sup>E</sup> by land  
 of Israel Gray, to the N<sup>W</sup> & SW part Joseph Scott & part Vacant  
 Land, and hath such shape and Marks as the above Plat  
 Represents, Survey'd the 12<sup>th</sup> dec<sup>r</sup> 1784, Phil<sup>m</sup> Waters D<sup>s</sup>  
 Recorded the 22<sup>nd</sup> April 1785.

