


State of S<sup>t</sup> Carolina, Pursuant to a warrant from John Thomas Esq<sup>r</sup> Commissioner of Locations, dated the 24 day of Febry 1785,  
I have admeasured and laid out unto William Denney a tract of two hundred and seven acres of land, situate in Ninety six district west of the ancient boundary on the branches of Nitchland Creek of Tidley river, Bounding on all sides on Vacant Land, and hath such shape and Marks as the above Plat Represents.

Surveyd. 10 March 1785,

by W<sup>m</sup> Benson D<sup>r</sup>


Recorded 12 May 1785.

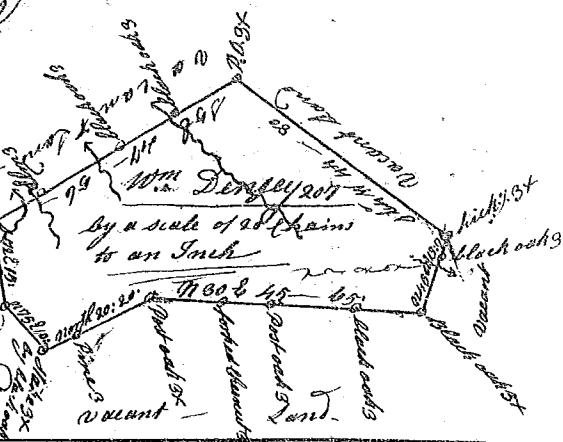

State of S<sup>t</sup> Carolina,

Pursuant to a warrant from John Thomas Esq<sup>r</sup> Commissioner of Locations Dated the 2d day of Febry 1785, I have admeasured and laid out unto Thomas Dunnigan a tract of one hundred acres of land, situate in Ninety six district west of the ancient Boundary on the branches of Boushey Creek of Enoree River, Bounding on all sides on Vacant Land, and hath such shape and Marks as the above Plat Represents, Surveyd. the 10th of March 1785,

Recorded the 12 May 1785, — by W<sup>m</sup> Benson D<sup>r</sup>

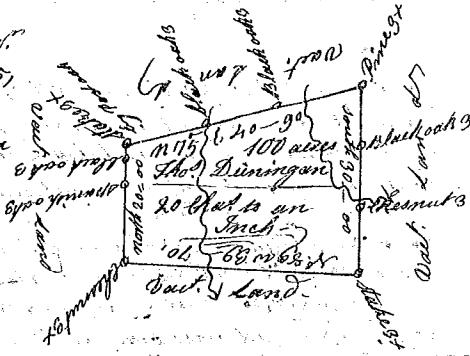


State of S<sup>t</sup> Carolina, — Pursuant to a warrant

from John Thomas Commissioner of Locations dated the 15th day of January 1785, I have admeasured and Laid out unto James Chastain a tract of one hundred and Thirty five acres of land, situate in Ninety six district West of the ancient boundary on Warren's branch of S<sup>t</sup> fork of Tugger River, Bounding S.E. on land granted to Henry Prince, 1788 1/4 M on the Ambulld Hill's land, N.W. to John Collins's land, all other sides on Vacant Land, and hath such shape and Marks as the above Plat Represents.

Surveyd. 14th April 1785,

by W<sup>m</sup> Benson D<sup>r</sup>

Recorded 12th May 1785.

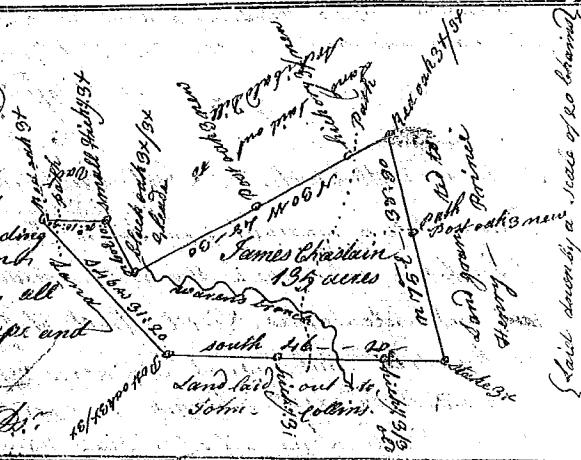

State of South Carolina,


Pursuant to a warrant from John Thomas Esq<sup>r</sup> Commissioner of Locations dated the 28 day of January 1785, I have admeasured and laid out unto Dennis Duff a tract of one hundred acres of land, situate in Ninety six district West of the ancient Boundary, on the branches of Musc-Cawke of S<sup>t</sup> fork of Tugger river, and a branch of Neys Creek of the N<sup>d</sup> fork of Saluda River, Bounding on all sides on Vacant Land and hath such shape and Marks as the above Plat Represents.

Surveyd. the 11th Feby 1785

by William Benson D<sup>r</sup>

Recorded 12th May 1785.

Laid down by a scale of 20 chains  
to an Inch

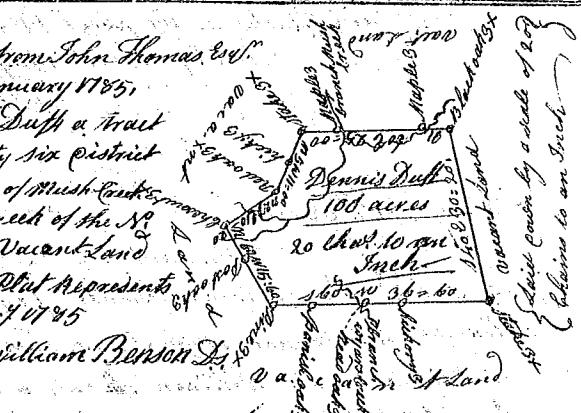

State of S<sup>t</sup> Carolina, Pursuant to a warrant from John Thomas Esq<sup>r</sup> Commissioner of Locations dated 21 day of January 1785, I have admeasured and laid out unto W<sup>m</sup> Martin a tract of land containing one hundred and Ninety one acres, situate in Ninety six district west of the old boundary, on the branches of Tidley River, and a branch of Armstrong's Creek, Bounding S.E. on land laid out to Nicholas Barnard & C to Charles Benson, all other sides on Vacant Land, and hath such shape and Marks as the above Plat Represents.

Surveyd. the 13th February 1785,

by W<sup>m</sup> Benson D<sup>r</sup>

Recorded 12 May 1785.

