


State of South Carolina ninety six district East of the ancient Boundary line

Pursuant to a warrant from John Thomas Esq. Commissioner of Locations dated the 21 day of March 1785, I have admeasured and laid out unto David Floyd a tract of Land containing 257 acres lying on the south side of Tyger River & on both sides of Ferguson's Creek, bounded N.W. by John Patton's land, S.W. by Enoch Floyd's land, N.E. by Tyger river, and hath such shape and Marks as the above Plat represents


Surveyed the 10 day of April 1785, recorded the 17th May 1785, by Andrew Thomson Esq.

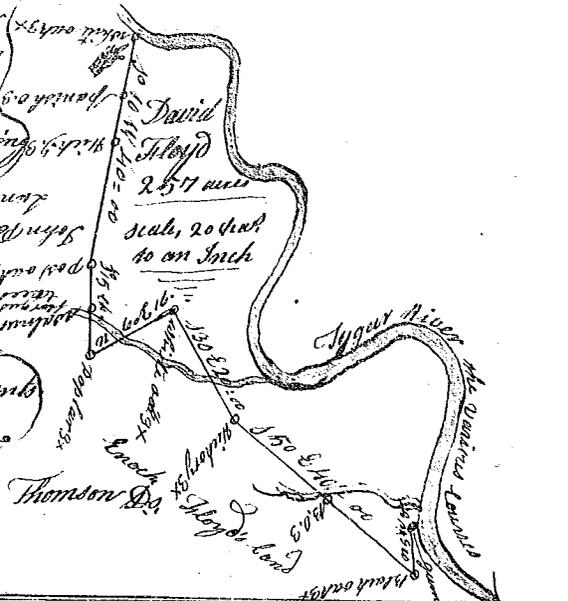

State of South Carolina 96 district East of the old Boundary line

Pursuant to a warrant from John Thomas Commissioner of Location, dated the 14th day of March 1785, I have admeasured and laid out unto George Park a tract of Land of 462 acres, lying on the north side of Fairforest on both sides of Harris's branch bounded S. & E. by said George Park and Andrew Thomson's Land N. & W. by Zachary Bulloch, and Robert Harris's Land, and James Mayo's Land, and hath such shape and Marks as the above Plat represents,

Surveyed the 19th March 1785, recorded the 17th May 1785, by Andrew Thomson Esq.

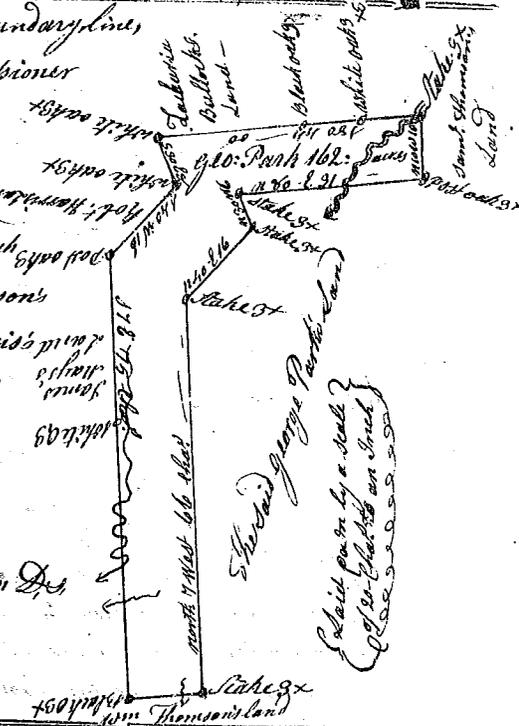

State of South Carolina 96 district west of the old Boundary line

Pursuant to a warrant from John Thomas Commissioner of locations dated 16 April 1785, I have admeasured and laid out unto Isaac Cause a tract of Land containing one Hundred and sixty acres lying on the N. side of Needy River, Bounded on all sides by vac. Land, and hath such shape and Marks as the above Plat represents, Surveyed 25 April 1785,

Recorded 17th May 1785, by Andrew Thomson Esq.

