



State of South Carolina 1785
 Pursuant to a warrant from the
 Esq. Comm. of locations for the growth of
 Saluda River I have surveyed and laid
 out unto Jacob Gardner a tract
 of Land containing 519 acres
 situate above the ancient boundary
 line on both sides of the
 River near the head, all including
 the head of same, and of 180
 Saluda southward by a survey
 known & measured by the
 good land fall other
 sides on vacant land &
 hath such shape & marks
 as the above plat represents
 Surveyed the 13 of April 1785
 Recorded the 13 of June 1785 James Seaborn Det.

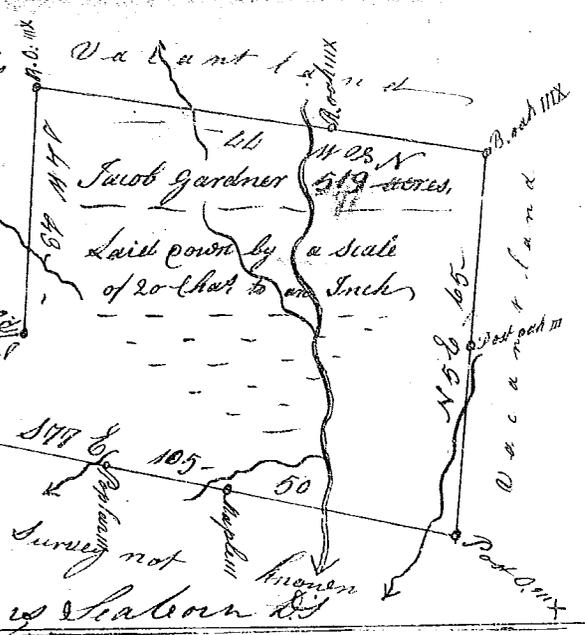

State of South Carolina 1785
 Pursuant to a warrant from the
 Esq. Comm. of locations for
 the West of the 180 of Saluda
 River I have surveyed and laid out
 unto Michael Dillingham a
 tract of Land containing 590
 acres situate above
 the ancient boundary line
 bounded Ewardly on on the
 180 of Saluda
 Swardly on Jackson's
 Land Westwardly on
 Wachig Dillingham's
 Land and all other sides
 on vacant land and
 hath such shape and marks
 as the above plat represents
 Certified the 13 of June 1785
 Recorded the 13 of June 1785 James Seaborn Det.

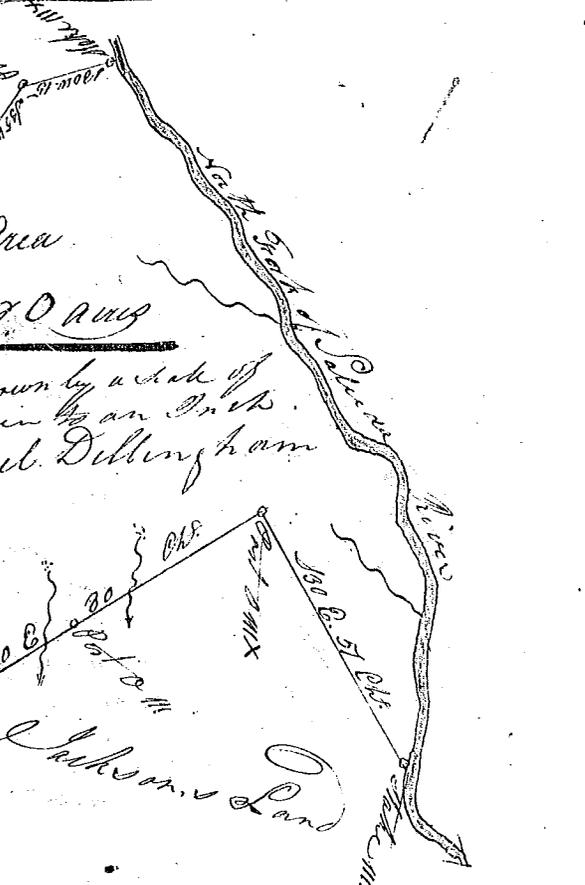

State of S Carolina Pursuant to a warrant from
 John Thomas Commissioner of locations I have
 admeasured and laid out unto John Inlow a tract
 of land containing two hundred acres situate in
 ninety six castwick on the waters of Duff's branch
 of Tyger river, bounding SW wily on land laid out
 to woodchert, all other sides on vacant land & land
 laid out, and hath such shape and marks as the
 above plat represents, Surveyed the 20 of April 1785,
 Recorded the 20 of June 1785, by Gardner and Hopkins Det.

