

State of S^t Carolina / Pursuant to a warrant from John Thomas Commissioner of locations, I have admeasured and laid out unto George Ruff a tract of one hundred and forty one acres of land, situate in Ninety six District on the waters of Second Creek a branch of Broad River, and hath such shape and Marks, buttins & boundings as the above plat represents.

Sunday, the 1st May 1785,

Recorded July 1785, J. Dougherty D.



Note of S^t. Carolina / Pursuant to a warrant from John

Thomas Commissioner of locations, I have admeasured and

Laid out unto George Ruff a tract of sixty six acres of land

situate in Ninety six District on the waters of Second Creek

a branch of Broad River, and hath such shape and Marks,

buttings and boundings as the above Plat represents,

Recorded the 6th July 1785, J. Dougherty D.

by J. Dougherty D.

Note of S^t. Carolina / Pursuant to a warrant from John Thomas Commissioner of locations, I have admeasured and laid out unto

George Carmer a tract of one hundred and twelve acres of land

situate in 96 District on the waters of Cannons Creek, a branch of

Broad River, and hath such shape, Marks, buttins and boundings

as the above plat represents, Surveyd. 6th May 1785.

Recorded to July 1785, J. Dougherty D.



Note of S^t. Carolina / Pursuant to a warrant from John Thomas

Commissioner of locations, I have admeasured and laid out unto


George Carmer a tract of forty six acres of land

situate in Ninety six District, on the waters of Second Creek a

branch of Broad River, and hath such shape, Marks, buttins and

boundings as the above plat represents, Surveyd. 11th May 1785.

Recorded the 6th July 1785, J. Dougherty D.

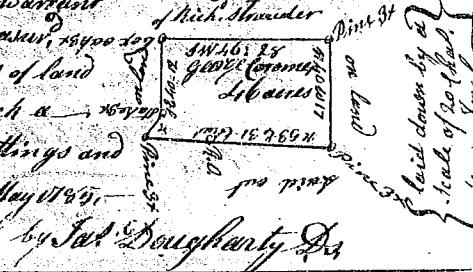

Note of S^t. Carolina / Pursuant to a warrant from John

Thomas Commissioner of locations dated the 5th day of May 1785

I have admeasured and laid out unto James Kinney a tract

of one hundred and thirty three acres of land, situate in 96


District on the North of Saluda River, on waters of Saluda River

Bounding S.W. on Lovis Land N.W. on Wm. Burgess Land N.E. on Vaet

Land S.S.E. on James Robert Mayson's land, And hath such shape and

Marks as the above plat represents, Sunday 16 May 1785.

Recorded to July 1785, J. Dougherty D.

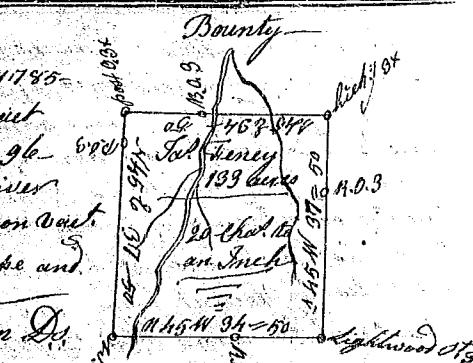

Note of S^t. Carolina / Pursuant to a warrant from John

Thomas Commissioner of locations dated the 30 June 1785, I have

admeasured and laid out unto David M. David a tract of

Ninety five acres of land, situate in Ninety six District N.E.

of Saluda River, N.W. of the old boundary on Somel Creek of

Reedy River, and hath such shape and Marks, buttins

and boundings as the above Plat represents.

Surveyd. the 1st day of July 1785, by J. Joseph Whitney D.

Recorded 11th July 1785, J. Joseph Whitney D.

