


(178)


State of S^t Carolina Pursuant to a warrant
Lawrence County from John Thomas Commissioner
of locations dated 30 May 1785, I have admeasured
and laid out unto William Hix abstract
of six hundred and forty acres, below
the old boundary, on a branch called
Burkes Creek, waters of Reburns Creek,
bounding & on lands of Duncan Bryant
and Hastings Dill, and all other sides
on land not known, and hath such
shape form and marks as the above
Plat represents, Surveyd 16 July 1785.

Recorded 20 July 1785 John Rodger, D^r
Del. the^t Martin

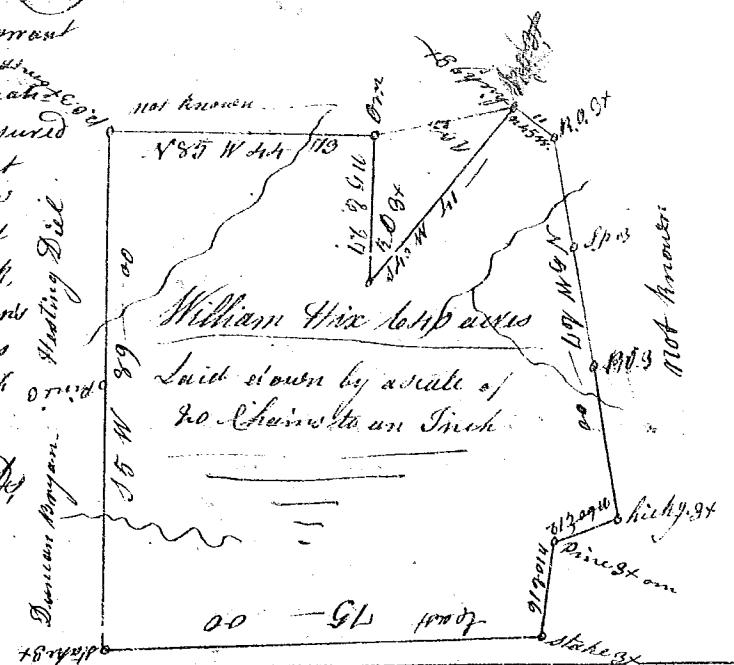


State of S^t Carolina Pursuant to a warrant from
Lawrence County John Thomas Commissioner
of locations dated 21 May 1785
I have admeasured and laid out unto William
Martin below the old boundary on Todd's branch
waters of Reburns Creek, six hundred & forty acres
bounding & on land of John Martin's W^t on
land of Robt. Todd's & on land of John
Swainson's and all the other sides on land
not known, and hath such shape, form
and mark as the above Plat Represents
Surveyd 16th June 1785

by John Rodger, D^r, P^r
Recorded 20 July 1785
Del. the^t Martin

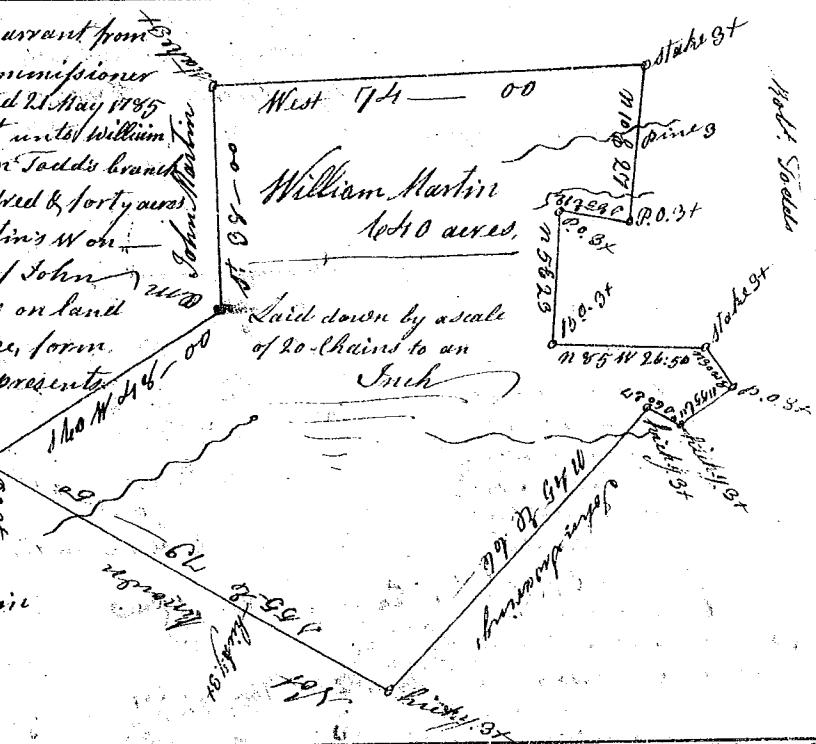

State of South Carolina
Lawrence County Warrant to

a Warrant from John Thomas Esq^r Comm^r
of Locations Dated the 23^d day of June 1785. Have
Admeasured and laid out unto James Sullivan
a tract of two hundred acres of land on Willard's
Creek below the ancient Boundary, Bounding N^o 1
Land of Robt. Rogers East on John Martin's W^t on the
West on John Martin & hath such shape form & marks as the above Plat Represents

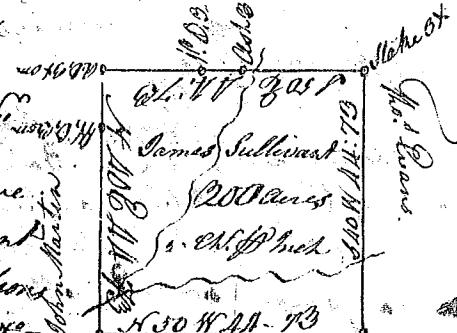

Surveyd this 28^d day of June 1785

Recorded the 20th July 1785
Deliv^d to Stephen Martin

John Rodger, D^r