State of South Carolina / Pursuant to a warrant from John Thomas Esq.r Commissioner of Locations I have admeasured and laid out unto Richard Minter a tract of 327 acres of land situate in Union County and ninety six District below the ancient Limits on three small branches running into Enoree River, and hath such shape, Marks, Buttings and boundings as the above Plat Represents

Survey.d the 19th July 1785,

by Abel Pearson D.s

Recorded 9th Sept.r 1785

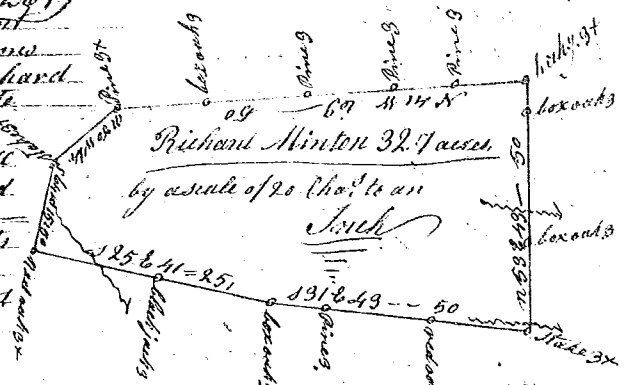

State of South Carolina / Pursuant to a warrant from John Thomas Esq.r Commissioner of locations, I have admeasured and laid out unto Richard Minton a tract of 312 acres of land — Situate in Union County ninety six District on a small branch running into Page's Creek, Bounded W by land laid out to John Clarke, S by land laid out to Joseph Howell, E by land laid out to Roger Page N by land laid out to John Conrad and Thomas Minton, and hath such shape & Marks as the above Plat Represents,

Surv.d the 20 th July 1785,

by Abel Pearson D.s

Recorded the 9th Sept.r 1785,

State of South Carolina / 96 District, East of the old boundary line, Pursuant to a warrant from John Thomas Esq.r Commissioner of location Dated 22 July 1785, I have admeasured and laid out unto Jonathan Nisbett a tract containing one hundred and fifteen acres, situate in Spartanburg County, on the south side of the South fork of Tygar River, bounded W.d by William Earnest land S.d by James gibsons land, E by — James Brights land. N.d by the S.d fork of Tygar river, and hath such shape and Marks as the above Plat Represents,

Recorded 9th Sept.r 1785,

Surv.d the 23 July 1785,

Andw. Thomson D.s

State of South Carolina,

Pursuant to a warrant from John Thomas Esq.r Commissioner of locations in 96 District on Saluda River, I have admeasured and laid out unto John Blackstock a tract of land containing one hundred and fifty acres, on a branch of Enoree, call.d Coxes branch, below the Indian boundary, bounding S.E.r & S.W.r & N.W — Partly on land laid out to Margret M.c Cullley, and part on land laid out to angus Campbel, all other sides on vacant land and hath such shape and Marks as the above Plat Represents

Surv.d, the 10th day of aug.t 1785, by Rob.t Hanna D.s

Recorded 9th Sept.r 1785.

State of South Carolina / Pursuant to a warrant from John Thomas Esq.r Commissioner of locations, dated the 10th day of May 1785, I have admeasured and laid out unto John Callaghan a tract of land containing one hundred and Ninety Eight acres, lying on both sides of Hadleys Creek, Bounded W.d by W.m Davis land, E.d by — — Willsons land, all other sides vacant land, and hath such ~~shape~~ shape and Marks as the above Plat Represents, Surv.d 1st July 1785,

Recorded the 9th Sept.r 1785,
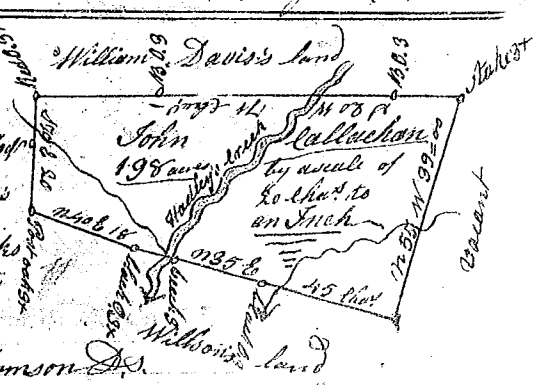
by Andrew Thomson D.s