


State of South Carolina

Pursuant to a warrant from John Thomas Esq^r Commissioner of Locations dated the 23 day of April 1785, I have admeasured and laid out unto John Pyle Sub tract of land containing six hundred and forty acres 600±
of land situate in Ninety six District on a branch of the Reedy fork of Reedy River called Pyles branch above the ancient boundary line, bounded S.E. on hence Black land, all other sides on Vacant Land, and hath such shape and Marks as the above Plat represents,
Surveyd the 1st day of May 1785.

By Jonthth Downs Esq
Recorded 9 Sept^r 1785.

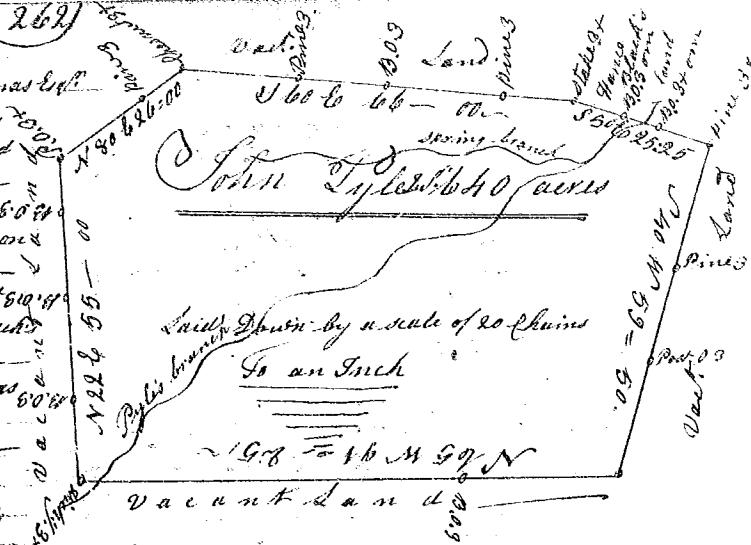


State of South Carolina Pursuant to a

warrant from John Thomas Esq^r Commissioner of Locations dated 23d April 1785, I have admeasured and laid out unto John Pyle Sub tract of land containing four hundred acres situate in 96 District on a branch of Reedy River call^d the springy branch above the ancient boundary line, bounded on all sides as above mentioned, and hath such shape and Marks as the above Plat represents,

Surveyd the 26th June 1785,

Recorded 9 Sept^r 1785 by Jonthth Downs Esq

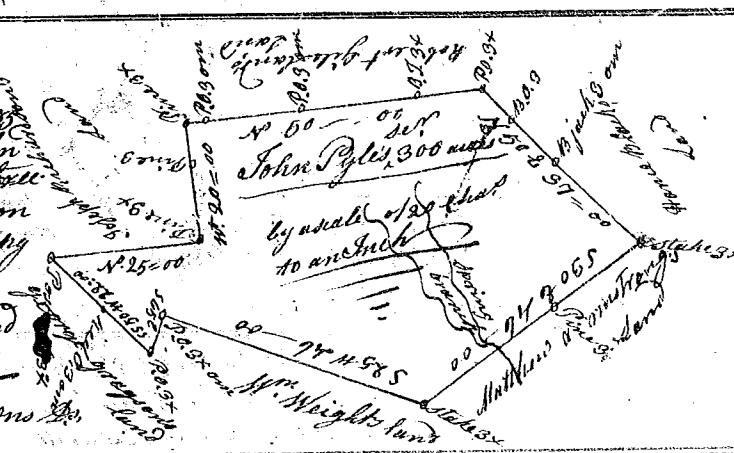

State of South Carolina

Pursuant to a warrant from John Thomas Esq^r Commissioner of Locations dated the 23d June 1785, I have admeasured and laid out unto James Floyd tract of land containing four hundred and seventy five acres, situate in Ninety six dist^t above the ancient boundary line, upon the Millstone and Cabin branch, waters of Reedy River bounded on all sides as above mentioned, and hath such shape and Marks as the above Plat represents, Surveyd 1st day July 1785.

Recorded 10th Sept^r 1785,

by Jonthth Downs Esq



Matthew Armstrong



State of South Carolina
Pursuant to a

warrant from John Thomas Esq^r Commissioner of Locations dated the 23 day of April 1785, I have admeasured and laid out unto Hance Black tract containing Two hundred and Twenty acres of land, situate in the District of 96 above the ancient boundary line, on the Ridgion-Hoost branch, waters of Reedy River, bounded N.W. on Matthew Armstrong's land, all other sides on Vacant land, and hath such shape and Marks as the above Plat represents, Surveyd the 1st June 1785.

Recorded the 10th Sept^r 1785

by Jonthth Downs Esq