
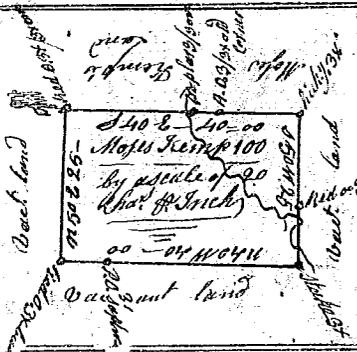


State of South Carolina,

1785

Pursuant to warrant from John Thomas Esq^r Commissioner of locations dated 4th July Saluda river, I have admeasured and laid out unto Obedia Hooper set a tract of one hundred and ninety four acres of land, situate in 96 District on the waters of Saluda River, and hath such shape, marks, buttings and boundings as the above Plat represents, Surveyed 24th Aug^r 1785 by Rob^t France D^y
Recorded the 30th Sept^r 1785

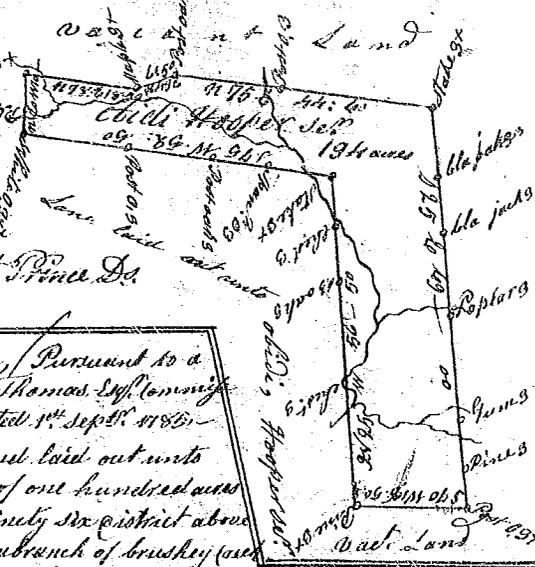


State of South Carolina, Pursuant to a warrant from John Thomas Esq^r Commissioner of locations dated 1st Sept^r 1785, I have admeasured and laid out unto Moses Kemp a tract of one hundred acres of land, situate in ninety six District above the old boundary, on a branch of brushy creek of Snow River, and hath such shape, marks, buttings and boundings as the above Plat represents, Surveyed 14th Sept^r 1785, J. Whitner D^y,
Recorded 30th Sept^r 1785,



State of South Carolina Pursuant to a warrant from John Thomas Esq^r Commissioner of locations, Dated the 30th Aug^r 1785, I have admeasured and laid out unto John Malin a tract of sixty six acres, situate in 96 District on a branch of the Charon waters of Saluda River, and hath such shape, marks, buttings and boundings as the above Plat represents, Surveyed 1st day of September 1785, by John Young Sur^r D^y
Recorded 30th Sept^r 1785,



State of South Carolina 96 Dist^r Pursuant to a warrant from John Thomas Commissioner of locations, 4th of Saluda River above the Indian boundary, I admeasured and laid out unto Alexander Glenn, a tract of land containing two hundred and fifty six acres, situate on the waters of Neelys River, on a small branch call^d Richland Creek bounding N^W and S^E, on David Goodletts land, also on Michael Johnstons land, also on John Thomas Esq^r land, all other sides on Vac^t Land, and hath such shape and marks as the above Plat represents, Surveyed 24th Sept^r 1785, by Jo^hn McClure D^y,
Recorded 1st Oct^r 1785,

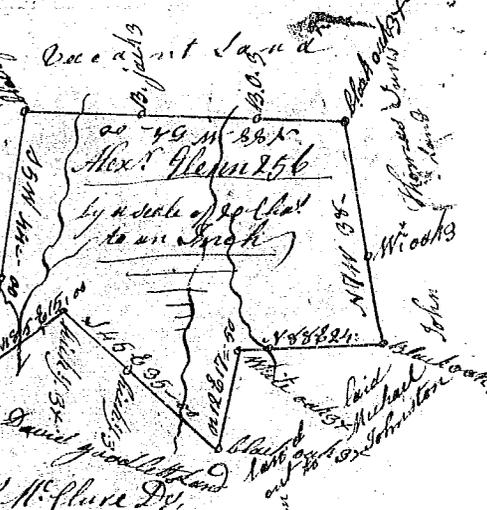

State of S^c Carolina Pursuant to a warrant from John Thomas Esq^r Commissioner of locations, I have admeasured and laid out unto Samuel Cooper a tract of 173 acres of land situate in Union County, 96 District below the ancient limits on the SW of Tiger River, and hath such shape, marks, buttings and boundings as the above Plat represents, Surveyed 1st Oct^r 1785, Abel Pearson D^y,
Recorded 3rd Oct^r 1785,



State of South Carolina Pursuant to a warrant from John Thomas Commissioner of locations, I have admeasured and laid out unto Samuel Cooper a tract of 140 acres of land situate in Union County & 96 District, below the ancient limits, on the N^E side of Tiger River, and hath such shape, marks, buttings and boundings as the above Plat represents, Surveyed 1st Oct^r 1785, Abel Pearson D^y,
Recorded 3rd Oct^r 1785,

