


State of South Carolina,



Pursuant to a warrant from John Thomas Esq. Commissioner of locations Dated the 26th day of Oct^r 1785, I have admeasured and laid out unto Giles Smith 319 acres of land, situate in Ninety six district, on both sides of French broad River, including Indian old fields on both sides of said River, and hath such shape, Marks, buttings and boundings as the above Plat represents, Survey^d 3. Nov^r 1785, Recorded 9th Nov^r 1785, — by Joseph Whitner D^s



State of S^c Carolina Pursuant to a warrant (Laid down by a State of 20 Ch^s to an Inch) from John Thomas Esq. Commis^r of locatⁿ N^o Saluda, Dated 19 Sept^r 1785, I have admeasured and laid out unto Simon Needer a tract of one hundred and thirty acres of land, situate in 96 District Saluda below the ancient boundary, on Kings creek, bounded NW. by Needer John Goodwires and Charles Kings lands, Part towards S. by Mulibin Monroes; Part towards SW. by William Naylor's land, all other sides by Vacant land and hath such shape, and Marks as the above Plat represents, Survey^d 28. Oct^r 1785, Recorded 9 Nov^r 1785, — by Phil^l Waters D^s

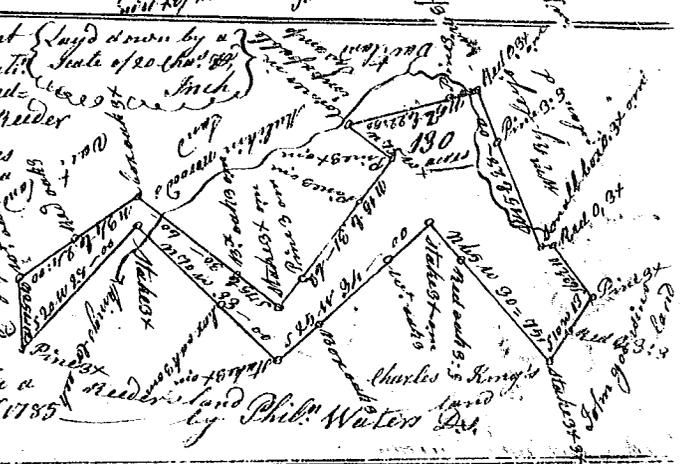

State of S^c Carolina Pursuant to a warrant from John Thomas Com^r of locⁿ dated 15 Sept^r 1785 I have admeasured and laid out unto William Naylor a tract of one hundred and thirty acres of land on Kings creek waters of Enoree, and hath such shape and Marks buttings and boundings as the above Plat represents 3. Oct^r 1785, Recorded 9th Nov^r 1785, — Phil^l Waters D^s

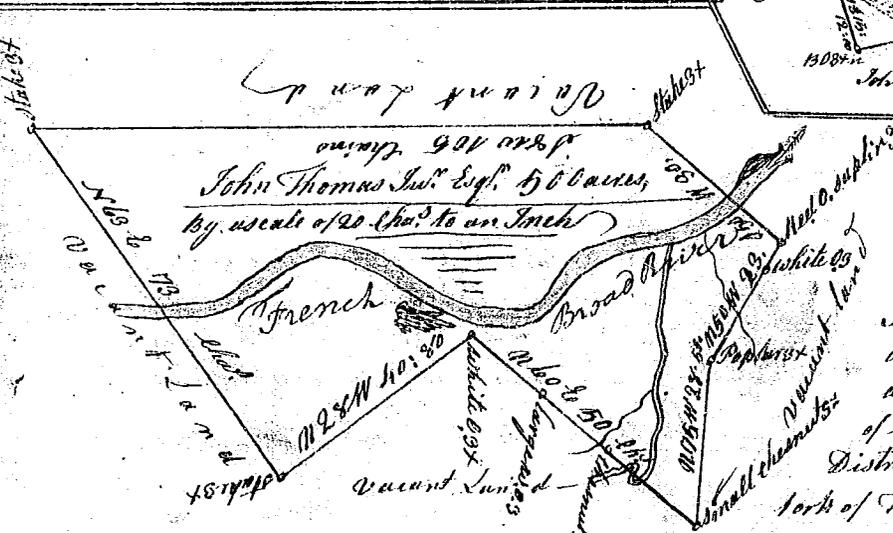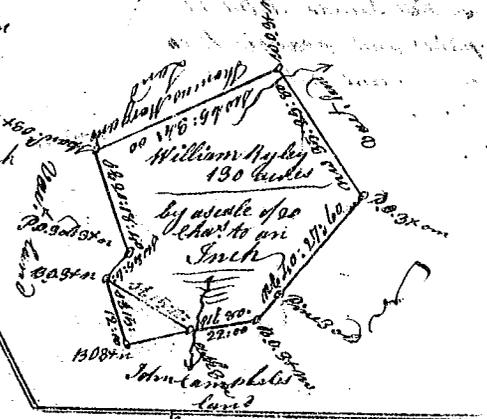

Pursuant to a warrant from John Thomas Esq. Commissioner of locations Dated the 26th day of Oct^r 1785, I have admeasured and laid out unto John Thomas Esq. a tract of five hundred acres of land, situate in Ninety six District, on both sides of the East fork of French broad River, all sides on Vacant land, — Survey^d 9. Nov^r 1785, Recorded 10th Nov^r 1785, — by Joseph Whitner D^s

State of South Carolina. Pursuant to a warrant from John Thomas Esq. Commissioner of locations dated the 25th Oct^r 1785, I have admeasured and laid out unto John Thomas Esq. a tract of five hundred acres of land, situate in Ninety six District, on both sides of the East fork of French broad River, all sides on Vacant land, — Survey^d 9. Nov^r 1785, Recorded 10th Nov^r 1785, — by Joseph Whitner D^s