

(304)













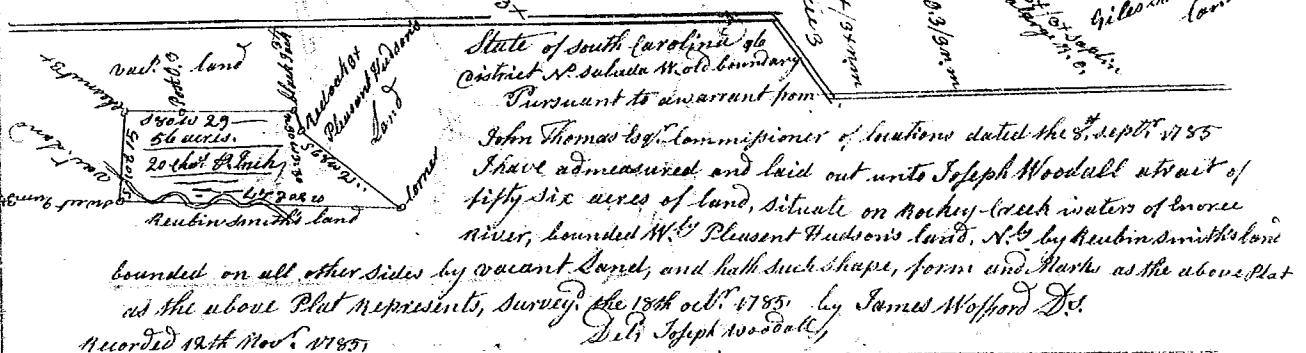

State of S. Carolina qd District N. of Saluda  
East of the Old Boundary. Pursuant to a warrant  
from John Thomas Esq; Commissioner of Locations dated the 11th Novr 1785  
1785. I have Admeasured of land out unto

James Gilbert a tract of land containing  
Two Hundred of fifty acres Situate lying S. to  
of Being On Indians Creek the water course  
of Enoree River. Bounded N. by Coddle  
Burkfield's Ht. by Richard Fowler's Ht.  
Ling. S. by William Gilbert's East by 2nd  
William's Land, & every year by Rd lines  
of having such shape form & marks as the above Plat Represents. Survey'd the 12th Novr 1785

Recorded 15th Novr 1785 Del'd the owner of

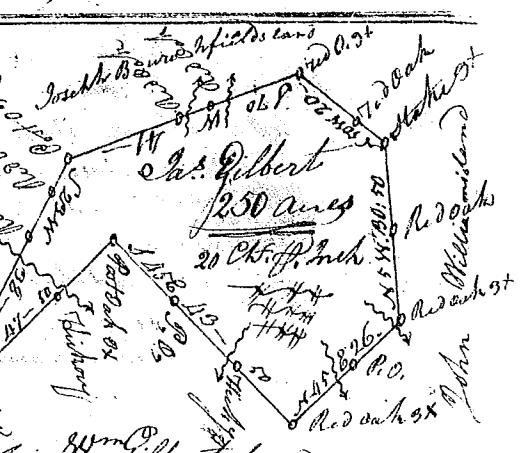

State of S. Carolina  
Pursuant to warrant from  
John Thomas Esq; Commissioner of Locations  
in qd District N. of Saluda  
Dated the 10th Novr 1785 I have Admeasured  
2 sum'd of land out unto John  
Edwards a tract of three hundred  
and eighty three acres of land  
Situate in Ninety Six District  
below the ancient Boundary  
On a Branch of Broad River

Called Indian Creek, bounded on all  
sides as are above mentioned & hath such  
shape & marks as the above Plat Represents

Survey'd this 19th Oct 1785

Recorded the 16 Novr 1785



John Edwards  
383 Acres

Survey'd this 19th Oct 1785