



State of S. Carolina Pursuant to a warrant (362)
 from John Thomas Esq. Comr. of Locations
 Dated the 19th Dec. 1785. I have admeasured
 and laid out unto William Flanahan Junr
 a Tract of Five Hundred acres of Land
 Situate in 96th District Below the 2^d
 Boundary, on Both sides of Ancers
 Creek of Enoree River, Including the
 Ready Fork of said Creek by hath such
 shape marks Buttings & Boundings as
 the above head Represents
 Surveyed the 2^d Feb. 1786
 Recorded this 23rd Feb. 1786
 Wm. Flanahan Junr.

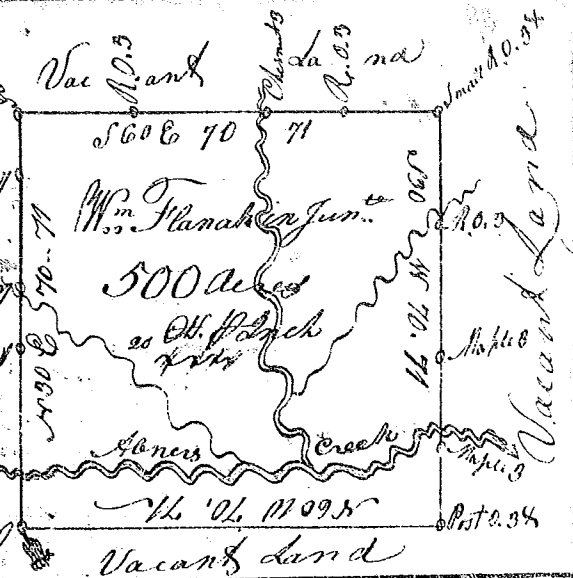

State of S. Carolina Pursuant to a warrant from
 John Thomas Esq. Comr. Locations Dated the 25th Oct. 1785
 I have admeasured & laid out unto William Benson a
 Tract of Land Containing 132 Acres. Situate in 96th
 District on Waccam's Creek of N. Carolina River, bound
 ing on all sides on Vacant Land by hath such shape by
 marking the above head Represents
 Surveyed this 6th Jan. 1786 W. Benson
 Recorded this 23rd Feb. 1786



State of S. Carolina Pursuant to a warrant
 from John Thomas Esq. Comr. Locations Dated the 25th
 Oct. 1785. I have admeasured & laid out unto Wm
 Benson a Tract of Land Containing Two Hundred
 & Twenty five Acres. Situate in 96th district 58th of
 Salsal River, Bounding by the Various Courses of said
 River and on all other sides by Vacant Land by hath such
 shape marks as the above head Represents
 Surveyed this 9th Nov. 1785 W. Benson
 Recorded this 23rd Feb. 1786

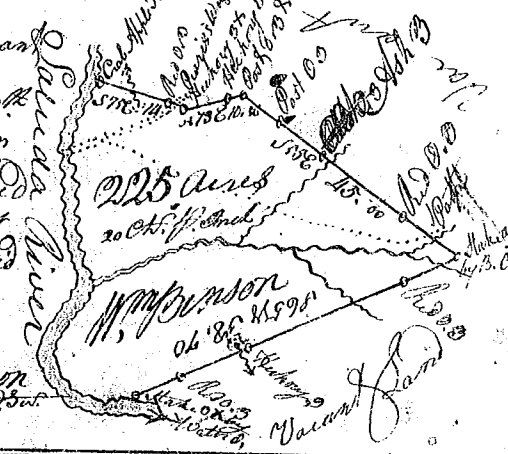

State of S. Carolina
 Pursuant to a warrant from
 John Thomas Esq. Comr. of Locations
 Dated the 2^d Day of Dec. 1785.
 I have admeasured & laid out
 unto William Swift a Tract
 of One Thousand acres of Land
 Situate in Ninety 6th District
 on both sides of Colthensons
 Beaverdam of Tiger River.
 And hath such shape and
 Marks Buttings & Boundings
 as the above head Represents
 Surveyed this 1st Jan. 1786
 by Geo. Salmon D.
 Recorded this 23rd Feb. 1786

