South Carolina,

Pursuant to a warrant from John Thomas, Esq.r Commissioner of locations for the N.o side Saluda River I have admeasured and laid out unto Enoch Benson, a tract of one hundred and Ninety three acres of land, in Ninety six District, on the waters of S.d Tygar river, and hath such buttings, boundings & other shape and Marks as the above Plat Represents, Surveyd 16. febr.y 1786

Recorded 3. May 1786. —

Rob.t Prince D.s

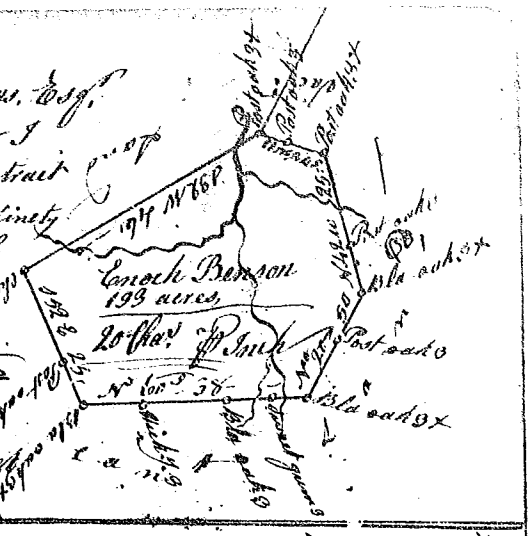

State of South Carolina, Pursuant to a warrant from John Thomas Esq.r Commissioner of locations, dated the 7.th febr.y 1786 I have admeasured and laid out unto Benjamin Bussey a tract of Six hundred and Seventy five acres of land, on Buffalow Creek, waters of Enoree River, Bounded E.ly by John Erwin's land & old lines, N.ly by Elijah Hendricks & James whittakers lands, W.ly by Jonathan Dildine & David Padelt's lands, S.ly by William & Robert Simbs Young & Hinkle's lands, and hath such shape form and Marks as the above Plat Represents, Surveyd 18.th febr.y 1786 By

James Wofford D.s

Recorded 4.th May 1786. —

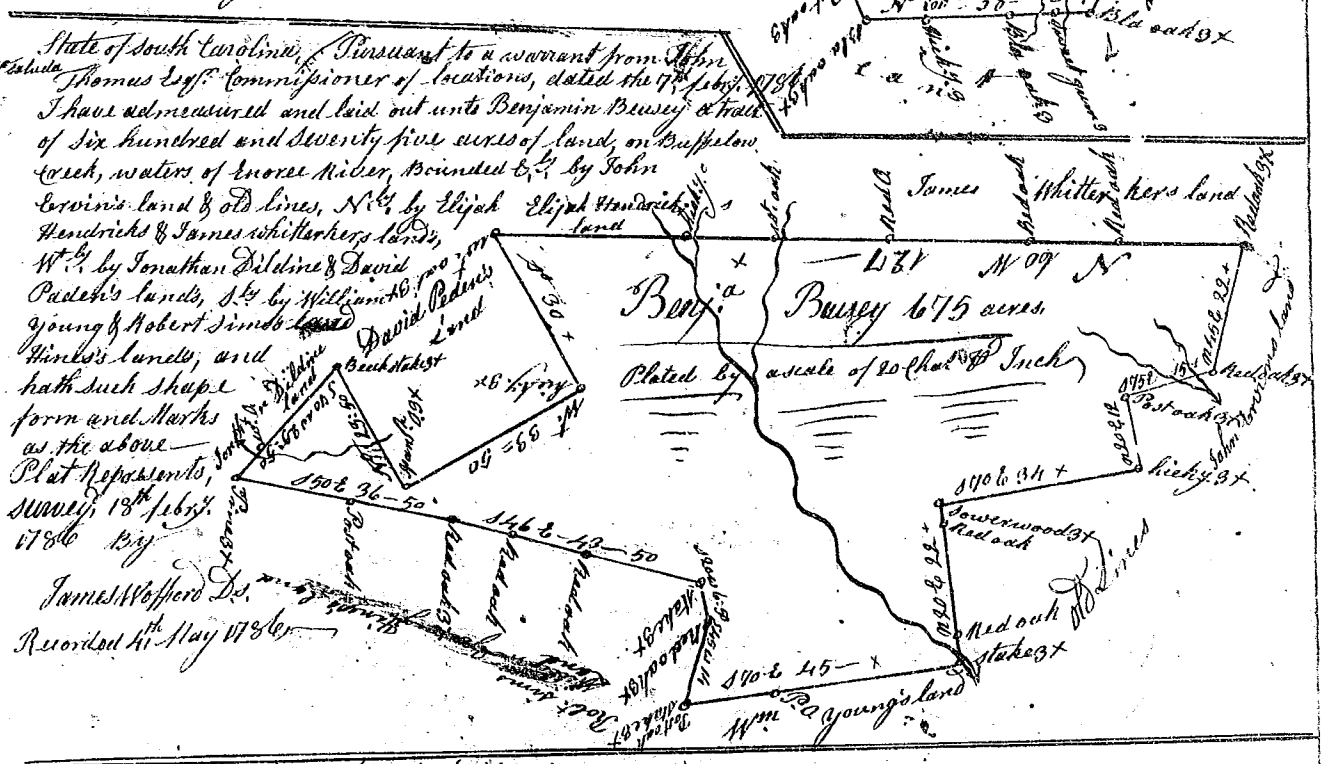

State of South Carolina, 96 District, N.o Saluda Pursuant to a warrant from John Thomas Esq.r Commissioner of locations, dated 23.d March 1786 I have admeasured and laid out unto Fredrick Burdit a tract of one hundred and ninety three acres of land, on a branch of Enoree River and Eastward by James Higgins & John Lindsey's lands and by old lines, N.ly by Rich.d Hotoler's land, S.ly by John Stone's called, and hath such form and Marks as the above Plat Represents,

Surveyd 29.th March 1786, James Wofford D.s

Recorded 4.th May 1786. —

John Stone's Land
Fredrick Burdit 193 acres
20 Chai.s pr Inch
Vacant land
