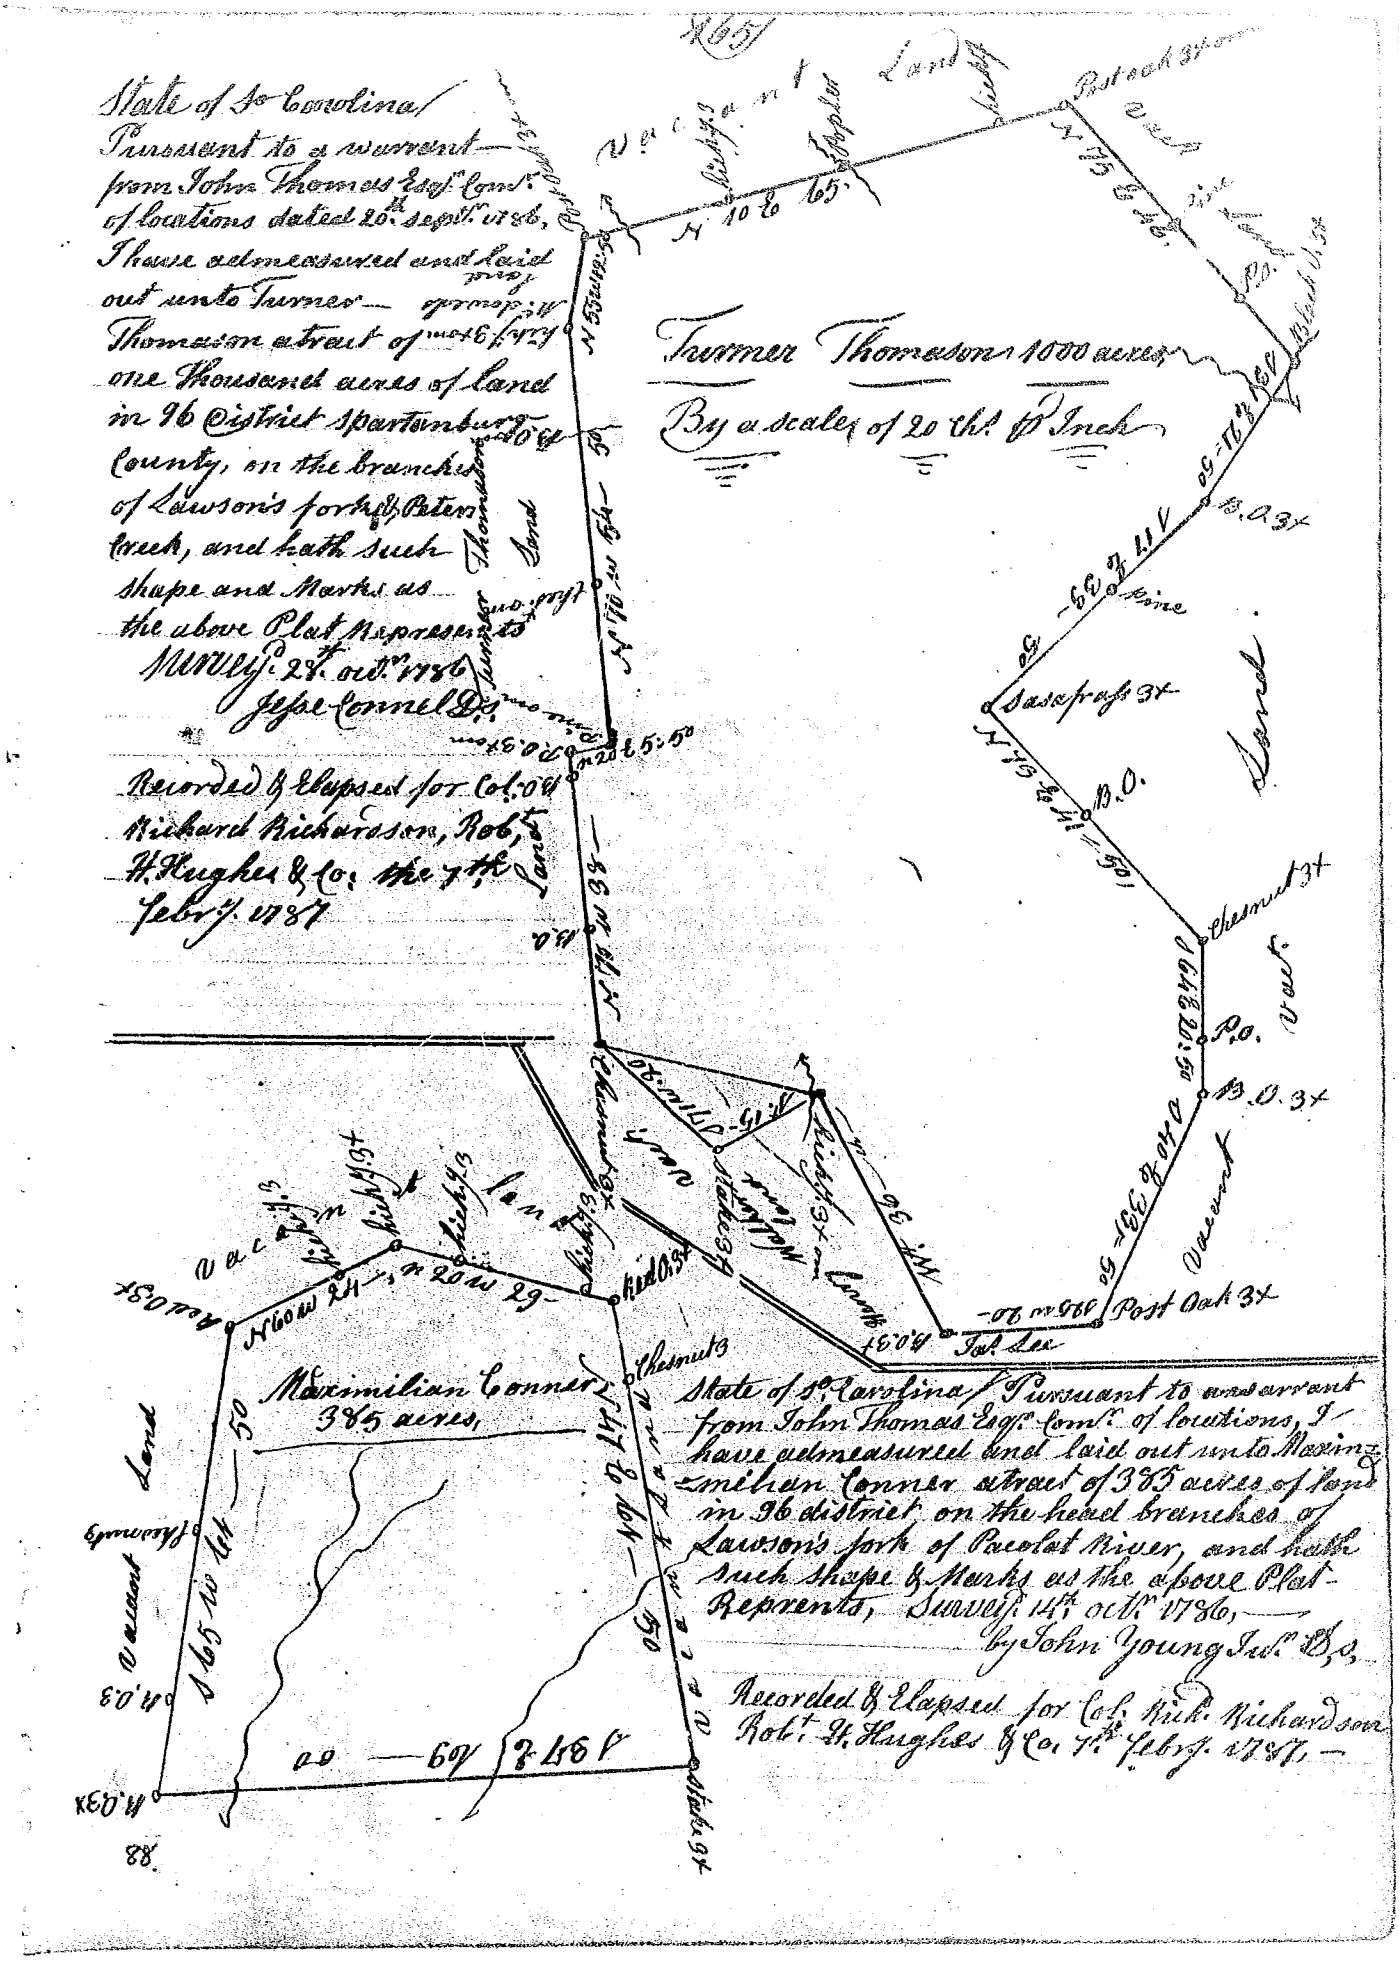
State of So Carolina
Pursuant to a warrant from John Thomas Esqr Comr of locations dated 20th Septr 1786, I have admeasured and laid out unto Turner Thomason a tract of 1000 acres of land in 96 District Spartanburg County, on the branches of Lawson's fork & Peters Creek, and hath such shape and Marks as the above Plat Represents
Survey'd 24 Octr 1786
Jesse Connel D.S.
Recorded & Elapsed for Col. Richard Richardson, Robt H. Hughes & Co. the 7th Febry 1787
Turner Thomason 1000 acres
By a scale of 20 ch to the Inch
Maximilian Conner 385 acres
State of So Carolina / Pursuant to a warrant from John Thomas Esqr Comr of locations, I have admeasured and laid out unto Maximilian Conner a tract of 385 acres of land in 96 district on the head branches of Lawson's fork of Pacolet River, and hath such shape & Marks as the above Plat Represents, Survey'd 14th Octr 1786, by John Young Surv B.O.
Recorded & Elapsed for Col. Rich. Richardson Robt H. Hughes & Co. 7th Febry 1787.
Land
Vacant
Post Oak 3x
Chestnut 3x
B.O. 3x
Sassafras 3x
Red O. 3x
Pine
88.