(286)

S.C. Carolina, Pursuant to a warrant from John Thomas Comr. of locations Dated 13th Octr. 1787. I have Admeasured and laid out unto William Smith a tract of 239 acres of land in 96 district on the waters of Tyger river, and hath such form and marks as the above Plat Represents, Survey. 24th Octr. 1787

Ben. Glenn Ds.

Recorded 27th Decr. 1787

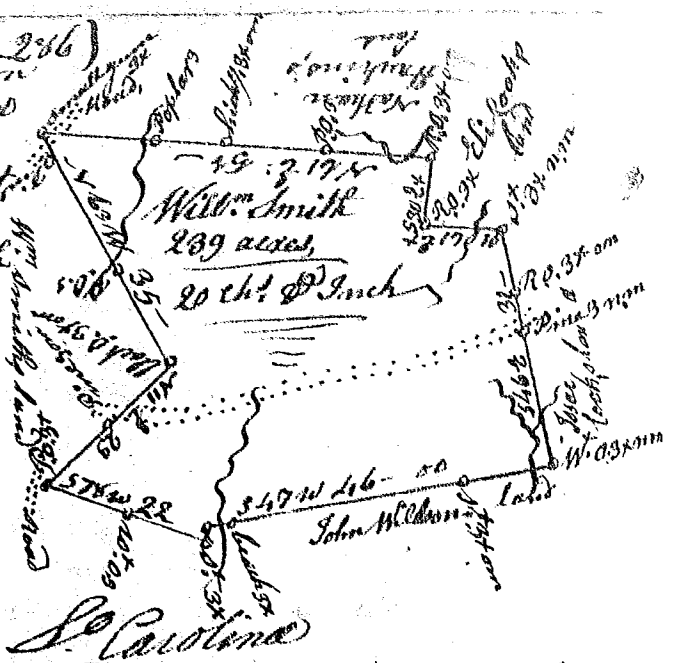

S.C. Carolina Pursuant to a warrant from John Thomas Esq. Comr. of locations dated the 13th Oct. 1787 I have admeasured & laid out unto Wm. Smith a tract of land containing 190 acres Situate in the district of 96 on the waters of Otterson Creek. Bounded as the above plat Represents. Surveyed 24th Oct. 1787

Recd. 27th Dec. 1787 and Recorded

Ben. Glenn D.S.

S.C. Carolina — Pursuant to a warrant from John Thomas Esq. Comr. of Locations in District dated the 13th day of October 1787 I have admeasured and laid out unto William Smith a tract of land containing 66 acres Situate in the district of 96 on the waters of Cane Creek & hath such form and marks, buttings and boundings as the above plat represents. Surveyed the 19th October 1787.

Recorded the 29th Decr. 1787 Ben. Glenn D.S.

Recorded to Self

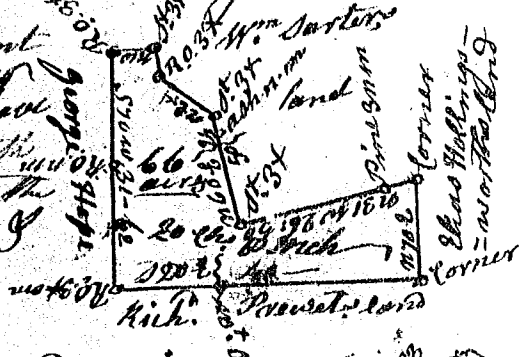

S.C. Carolina Pursuant to a warrant from John Thomas Esq. Comr. of locations dated the 13th October 1787 I have admeasured and laid out unto William Smith a tract of 26 acres of land. Situated in 96 district on a branch of Tyger River bounding on the line that runs S.E. on Mr. Hawkins's land N.E. on lands laid out to Wm. Woodyard S.W. James Hawkins's land, and hath such shape and marks, buttings & boundings as the above plat represents. Surveyed 21st Decemr. 1787 Ben. Glenn D.S.
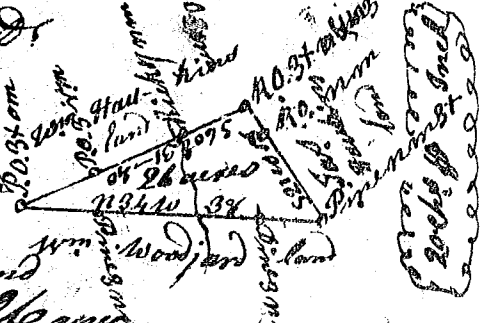
Recorded the 29th Decemr. 1787. Self