


State of South Carolina, Pursuant

to a warrant from John Thomas Esq^r Com^t of Locations Dated 2^d feby 1789,
I have admeasured and laid out
unto Thomas Brasher a tract of 300
acres of land, in Greenville County
on a branch of Reedy river called
Bakers Creek, Bounded S.E. on James
Heal's land, N.W. on Machmonaw.
Comers land, all other sides on back
out Land, and hath such shape,
marks, cuttings & boundaries as the
above Plat represents.

Surveyd. 9^d feby. 1789.

Recorded 14^d Sept^r 1789,


Southⁿ Divid. Dist.

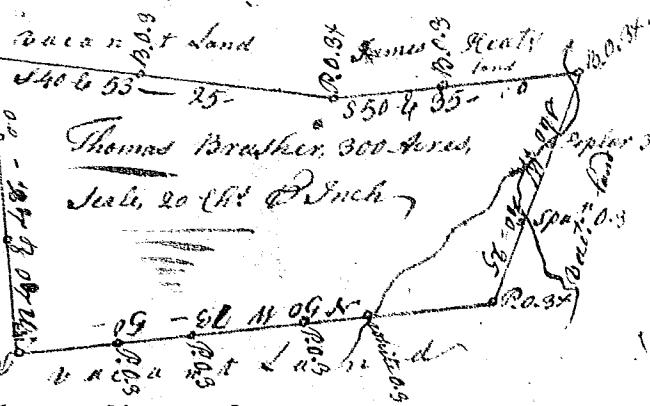

South Carolina, 96 District, Pursuant to a warrant from
John Thomas Esq^r Com^t of Locations Dated 4^d feby 1789, I
have admeasured and laid out unto James Bell a tract of
Ninety acres of land, in Union County on both sides of
Shady Creek a branch of fairforest, bounded N.E. by John
Boggs' land, S.E. by William Comer's and Isaac Boggs'
lands, S.W. by Col. Brandon's land, N. by George Young's lands,
Cryples & the said James Bell's lands,
and hath such shape & marks as the above
Plat represents, Surveyd. 9^d feby. 1789.

Recorded 15^d Sept^r 1789 Andrew Thomson D^r.

D. H. Brandon

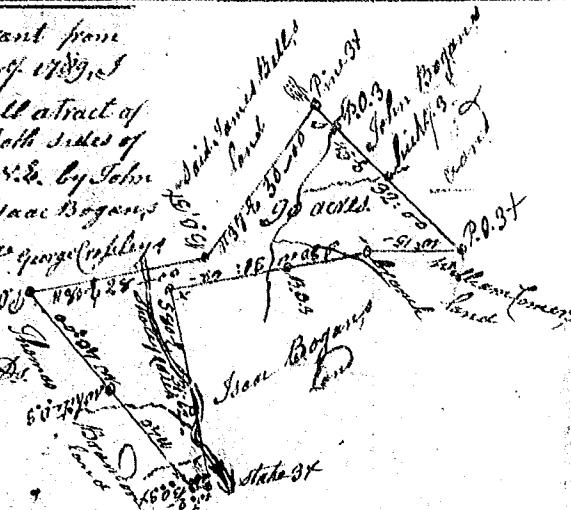

South Carolina

Pursuant to a warrant from John
Thomas Esq^r Com^t of Locations dated 5^d Aug. 1789,
I have admeasured and laid out unto Jesse Reams a tract
of One hundred & fifty two acres of land, in 96 Dis-
& Spartanburg County. on both sides of Milling
Branch of S.C. Paddelet River. bounded S. on H. Williams'
J.W. on James Hillman. J.W. on H. Williams'
J.W. J.S. on John Young's land. & hath such shape
form & marks as the above plat represents. Certified this 12^d Aug^r 1789
Rec'd the 16^d Sept^r 1789 D^r John



State of South Carolina, Pursuant to a warrant from John Thomas Esq^r Com^t of Locations
I have admeasured and laid out unto
Capt. James Terrill a tract of four hundred and
ninety five acres of land, in 96 District, on
the S. fork of Gibney's Creek, bounded E.
by the widow Scott's land, N. by vacant,
S. by lands the owners unknown
and hath such shape, form and
marks as the above plat represents,
Signed. Surveyd. 30 July 1789.

Recorded 29^d Sept^r 1789,

John Young land, D^r

