



State of S^c Carolina Pursuant to a warrant, (+ 200)

by James Dumming & S 80° E 228 yds. by land laid out for James Nicoll. North by land running S 61° 08' West 270 yds. by land laid out into the name Philip Sherrill. And by line running N 40° W 400 yds. by land laid out for John Sherrill. And by a line running S 20° E 280 yds. by land laid out for John Nicoll. West westerwardly by a line running S 36° E by land laid out for John Nicoll. And to said shape and marks, as the above Plat represents. Surveyed the 30th day of February 1792. And the 12th May 1792. Geo. Salmon Esq^r De^p.

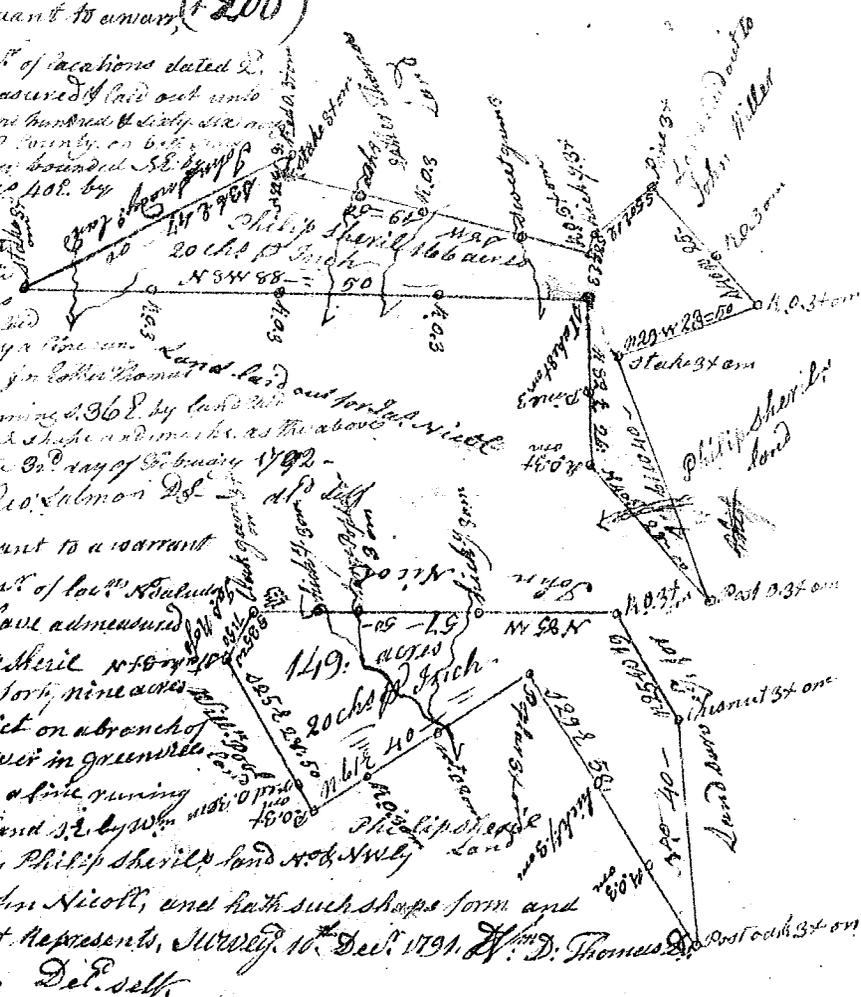


State of S^c Carolina Pursuant to a warrant

From John Thomas Esq^r Com^r of Vacations dated 10th Dec^r 1791, I have admeasured and laid out unto Philip Sherrill a tract of one hundred & forty nine acres of land in said District on a branch of the Forks of Tugger river in Greenfield County, bounded by a line running S 35° W by James Hops land S 2° E by John Poles land N 28° S 2. by Philip Sherrill land and hath such shape form and marks as the above Plat represents. Surveyed 10th Dec^r 1791. And the 12th May 1792. De^p self.

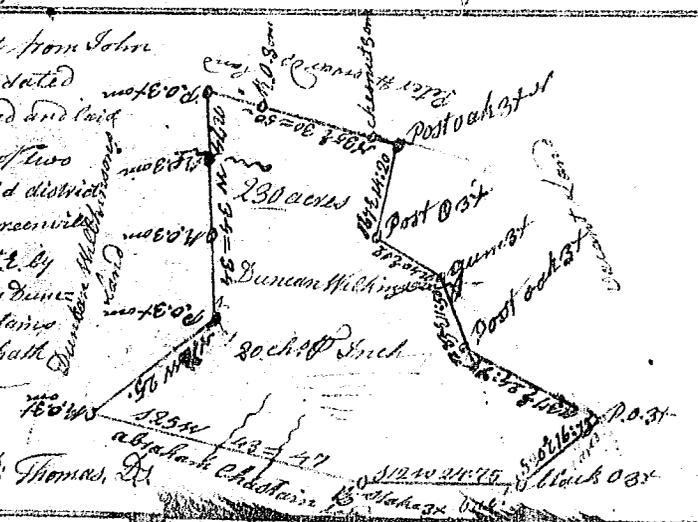

S^c Carolina Pursuant to a Warrant from John Thomas Esq^r Com^r of Vacations dated the 26th Nov^r 1791 I have admeasured and laid out unto Duncan Withins a tract of two hundred & thirty acres of land in said District on the Branches of S^c Tugger river in Greenfield County, bounded by a line running N 2° E by Peter Howards land N 74° W 416 yds, by Duncan Withins land S 4° E, by Abraham Chastain land & the other sides vacant land, and hath such shape & marks as the above Plat represents. Surveyed 30th Dec^r 1791. Recorded 12th May 1792. — W^m D. Thomas, De^p.

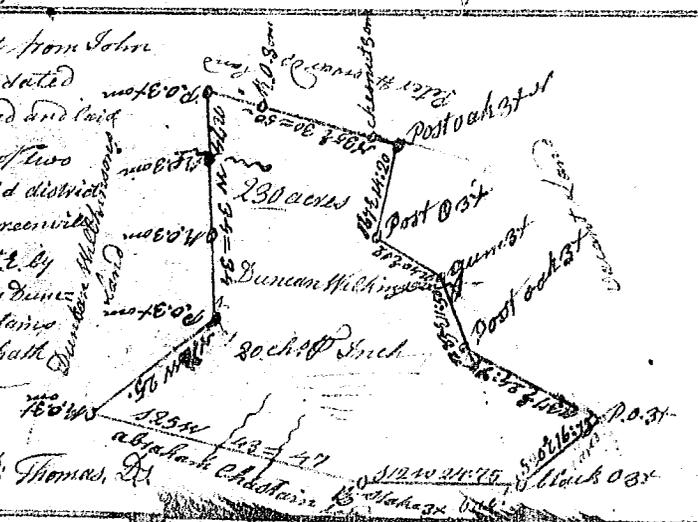

State of S^c Carolina Pursuant to a warrant from John Thomas Esq^r Com^r of Vacations I have laid out unto Archelus Fore a tract of 350 acres of land situate in Ninety six District on Tenors Creek, and hath such shape form marks & boundaries as the above Plat represents.

Surveyed the 7th May 1792.

Recorded 12th May 1792 — Charles Sims De^p.

