

State of S^t Carolina, Ninety-six District (204)

Pursuant to a warrant from the said Esq^r Commiss^r of Land Survey dated 25th Dec^r 1786 I have admeasured & laid out unto William Elder a tract of land bounded
and eighteen acres of land in Spartanburg County
situate on both sides of Duckman's Creek waters
of Tugger river, bounded N. E. by John Elder & H. W.
Smith, lands s.e. by William Smith land 3.56
by William Smith & Robert Sterling land 5.44
by Robert Sterling & Moses Purcell's lands and
 hath such shape and marks as the above Plat
Represents, Surveyd 24th Dec^r 1786.

Recorded 24th June 1792. — Sam'l Lancaster Esq^r
Attest to Judge Smith under seal.


S^t Carolina Pursuant to a warrant from John
Thomas Esq^r Comr^r of Locations dated 13th March 1792
I have admeasured and laid out unto John Fost^r
a tract of seven hundred and twenty three
acres of land in Pinckney District Spartan-
burg County on the head branches
of Beaver-dam creek of fairforest
bounded N. by Harrisons land Wingo's
and Fost^rs lands s.e. by Well's land
W. by Benson's land, all other sides by
vacant land, and hath such shape
Marks buildings and boundings as the
above Plat Represents.

Surveyd 1st May 1792. —

Jesse Cornell, Esq^r

Recorded 30th June 1792.

Attest John Hart

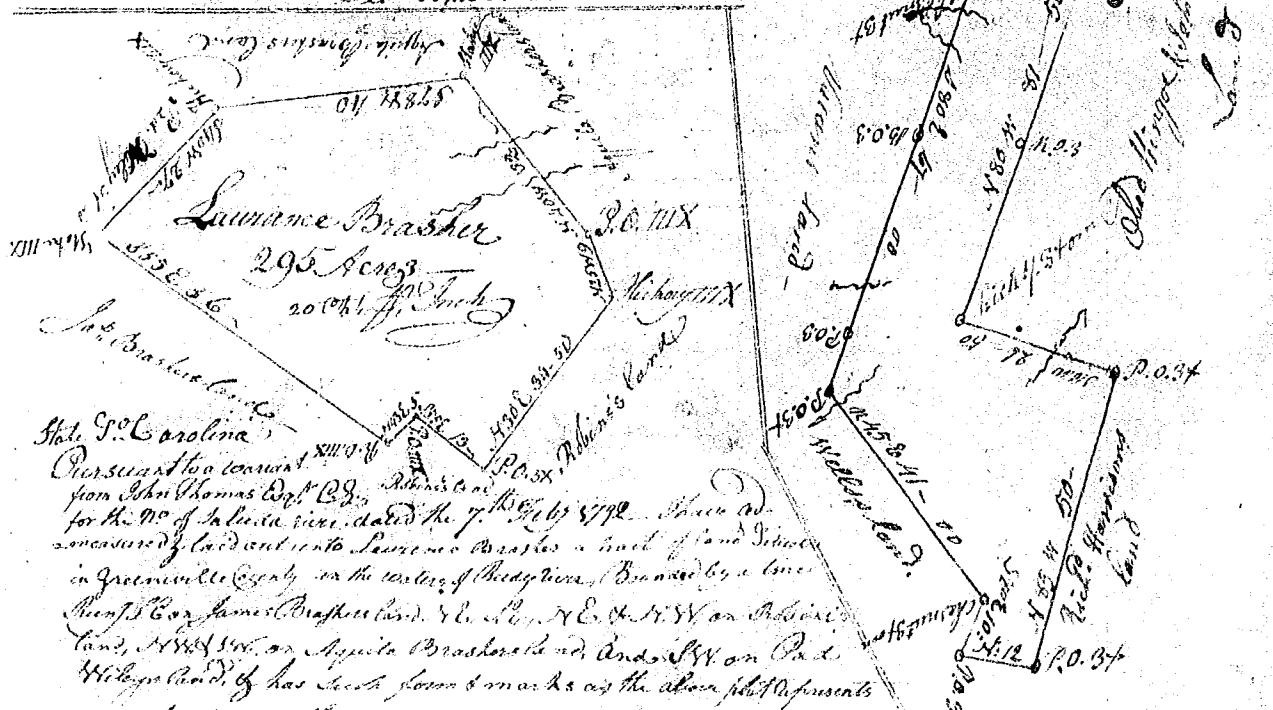

State of S^t Carolina

Pursuant to a warrant 8th J^l 1792 P. O. 34, Recd^r to me
from John Thomas Esq^r Comr^r of Locations dated the 7th Feb^r 1792. I have ad-
measured & laid out unto Lawrence Brashears a tract of land situate
in Greenville County in the valley of Ready river, bounded by a line
Run^d by James Brashears land, & E. & N. E. & N. W. on Adair's
land, N. S. & S. E. on Aquila Brashears land, and S. W. on Paul
Wicks land, & has such form & marks as the above plat Represents

Surveyd the 17th Feb^r 1792.

Attest James Scitton Esq^r

Recorded the 1st July 1792.