

State of S^t. Carolina Pursuant to a warrant from 2471

John Thomas Esq^r Com^r of loc^r N^r side Saluda

Dated 5th April 1793. I have abmeasured and laid

out unto H^r John Gowin about of one thousand

acres of land, in Washington District

and Pickney Districts on both sides of the

ancient Boundary line & now the line between

Spartanburg & Greenville County's on both sides

of South Pacolet river, Bounded by Lick^r & C^r

Runing W. S.W. & N.E. by Land granted to

general Wm^m Hollings w^r S. 10-18-50 by

unknown & I^d Bate's land N. S. E. N. E. S. E.

and S.W. S.W. Maj^r Gowin's land, S. S.E. S.W. and

N. E. by Land laid out for William Finch and

George Morrison, all other sides on Vacant


Land, and hath such shape form, buildings and

boundaries as the above Plat represents.

Survey 15th April 1793,

James Kilgore D^r.

Recorded 1st June 1793, Del. Done

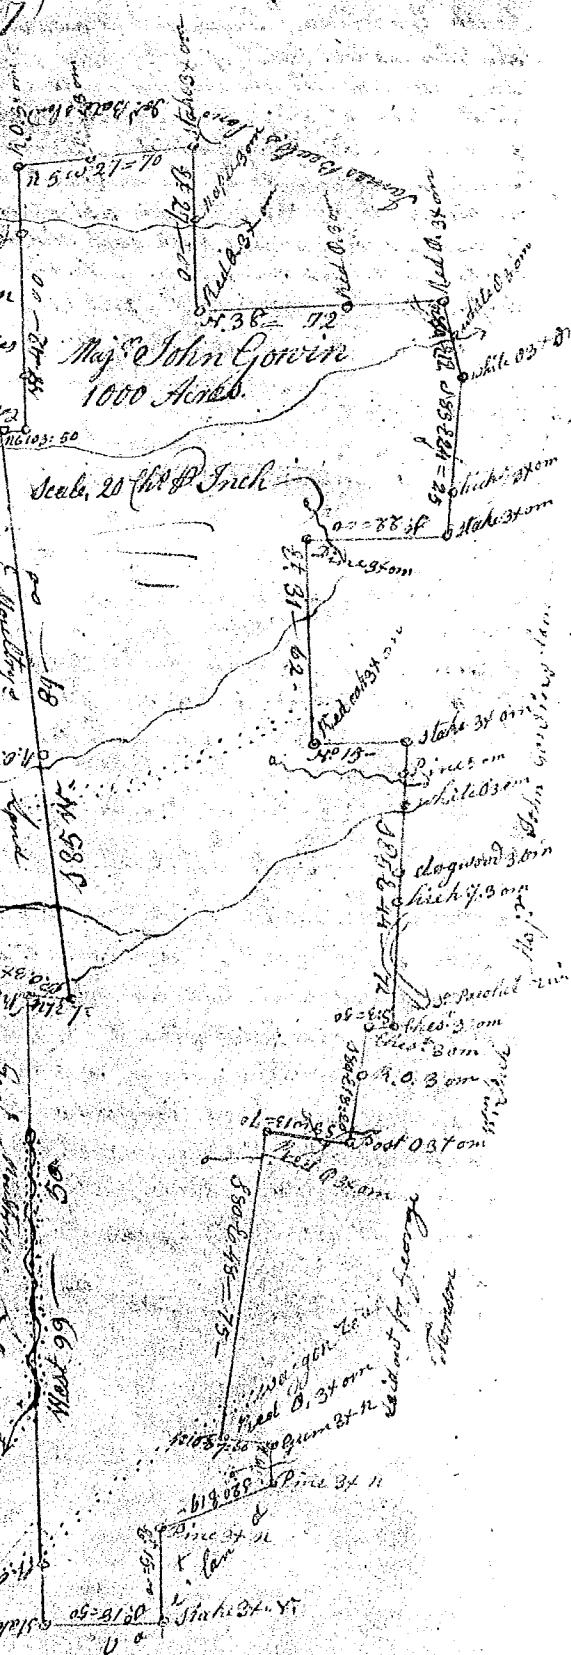

State of S^t. Carolina Pursuant

to a warrant from John Thomas Esq^r Com^r of Pees dated 5th day of February 1793. I have abmeasured and laid out unto Vincent Anderson about of five hundred & eighty eight acres of land, in Greenville County, on both sides of Vaughan's Creek of Chechescoa River waters of Saluda river. Bounded N.N. westerly on Land laid out for Thomas Garrow all other sides on Vacant land and hath such shape form and Marks as the above Plat represents.

M.W.C. J. G. H. 1793. G. Salmon D^r.

Recorded 2nd June 1793

