



John Thomas Esq. I have admeasured and laid out unto Nathaniel Walker a tract of sixty acres of land in Spartanburg County on the N. side of the 3<sup>rd</sup> fork of Tygar river bounded w<sup>estwardly</sup> by said river running S<sup>outh</sup> with old survey of 188<sup>8</sup> with Hugers land, and hath such shape & marks as the above plat represents Survey 25<sup>th</sup> Sept 1796, recorded 26<sup>th</sup> Jan<sup>y</sup> 1799, J. D. Solt



South Carolina, Pursuant to an warrant from John Thomas Esq. Com<sup>r</sup> of loc<sup>ks</sup> N<sup>o</sup> side Saluda dated 25<sup>th</sup> Sept 1797. I have admeasured and laid out unto Nathaniel Walker a tract of five hundred acres of land in Pinkney District between the 3<sup>rd</sup> fork & Middle fork of Tygar River Spartanburg County, bounded by Lines running N<sup>o</sup> & S<sup>o</sup> by land unknown N<sup>o</sup> E. by Nathaniel Walker N. & S. E. by land surveyed for John Leach, the other sides by the above mentioned rivers, and hath form & marks as the above plat represents Survey 3<sup>rd</sup> febr<sup>y</sup> 1797, recorded 4<sup>th</sup> febr<sup>y</sup> 1797, J. D. Thomas Esq. D. Solt

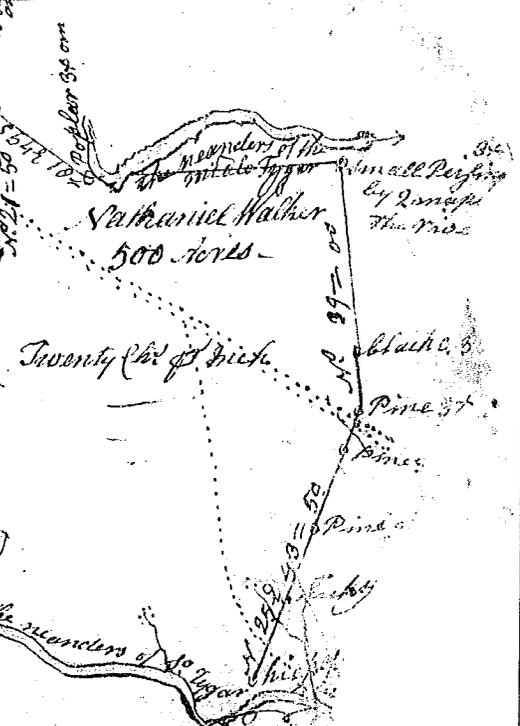

South Carolina Pursuant to an warrant from John Thomas Esq. Com<sup>r</sup> of loc<sup>ks</sup> N<sup>o</sup> side Saluda dated 5<sup>th</sup> Jan<sup>y</sup> 1797 I have admeasured and laid out unto Henry Mitchem a tract of four hundred & sixty seven and a half acres of land situate in Pinkney District Spartanburg County on Little Shokey Creek waters of Lawsons fork, bounded by John Kellys on the N<sup>o</sup> and on all other sides by vacant land, and hath such form & marks as the above plat represents Survey 9<sup>th</sup> Jan<sup>y</sup> 1797, recorded 14<sup>th</sup> Jan<sup>y</sup> 1797, Gabriel Berenson Esq.

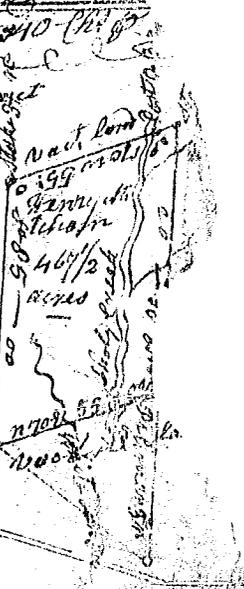

South Carolina Pursuant to an warrant from John Thomas Com<sup>r</sup> of loc<sup>ks</sup> N<sup>o</sup> side Saluda dated 15<sup>th</sup> April 1797 I have admeasured and laid out unto John Clarke a tract of one hundred and sixty six acres of land in Pinkney District Spartanburg County on both sides above Kilpatrick's Creek of the Pacolat river bounded S<sup>o</sup> by land surveyed for John Bondie & Thomas Neel, E<sup>st</sup> by land surveyed for William Gilbert, N<sup>o</sup> West by vacant land, and hath such form and marks as the above plat represents Survey 20<sup>th</sup> Nov<sup>r</sup> 1794, recorded 15<sup>th</sup> April 1797, John Young Esq. D. Solt

