

State of Carolina

Pursuant to a warrant from John Thomas Esq. Com. of loc. dated the 22<sup>nd</sup> Oct. 1795. I have

admeasured & laid out unto Wm Davis Tho. a tract of 500 acres of land, situate on the head branch of the

wards creek & branches of the Fork creek of South Tigar river: In Greenville County bounding by lines run N.W. by land granted to J. Thomas jun. S.W. by John Watson, N.E. by unknown land No. 8 & N.E. by Peter Land's N.W. by the Ancient Indian boundary, & hath such form & marks as the above plat represents.

Survey'd the 19<sup>th</sup> of Nov. 1795. Wm. D. Thomas Sur. Recorded the 27<sup>th</sup> March 1797. Det. Self




South Carolina Pursuant to a warrant from John Thomas Esq. Com. of loc. dated the 14<sup>th</sup> March 1797. I have

admeasured and laid out unto John Edes Morrow a tract of four hundred & thirty one acres of land situate in Pinkney District Spartanburg County on the branches of Island Creek waters of Pacolat river

bounded by a line running S.E. by unknown land, all other sides vacant land, and hath such form & marks as the above Plat represents.

Recorded 3. april 1797 Survey'd 3<sup>rd</sup> March 1797. Gabl Benson D.

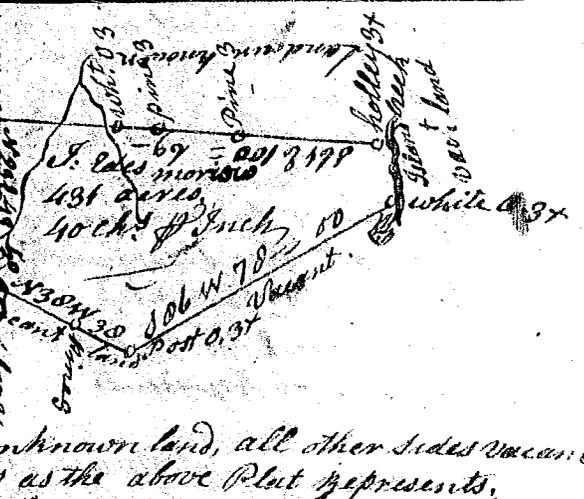

South Carolina Pursuant to a warrant from John Thomas Esq. Com. of loc. dated the 14<sup>th</sup> March 1797. I have

admeasured and laid out unto Jesse Morrow a tract of four hundred and eighty six acres of land in Pinkney District Spartanburg County on the branches of Island Creek waters of Pacolat river & branches of Thickety Creek

bounded by John Edes Morrow's land on the N.W., all other sides vacant land and hath such form and marks as the above plat represents.

Recorded 3. april 1797 Survey'd 3<sup>rd</sup> March 1797. Gabl Benson D.

