1412

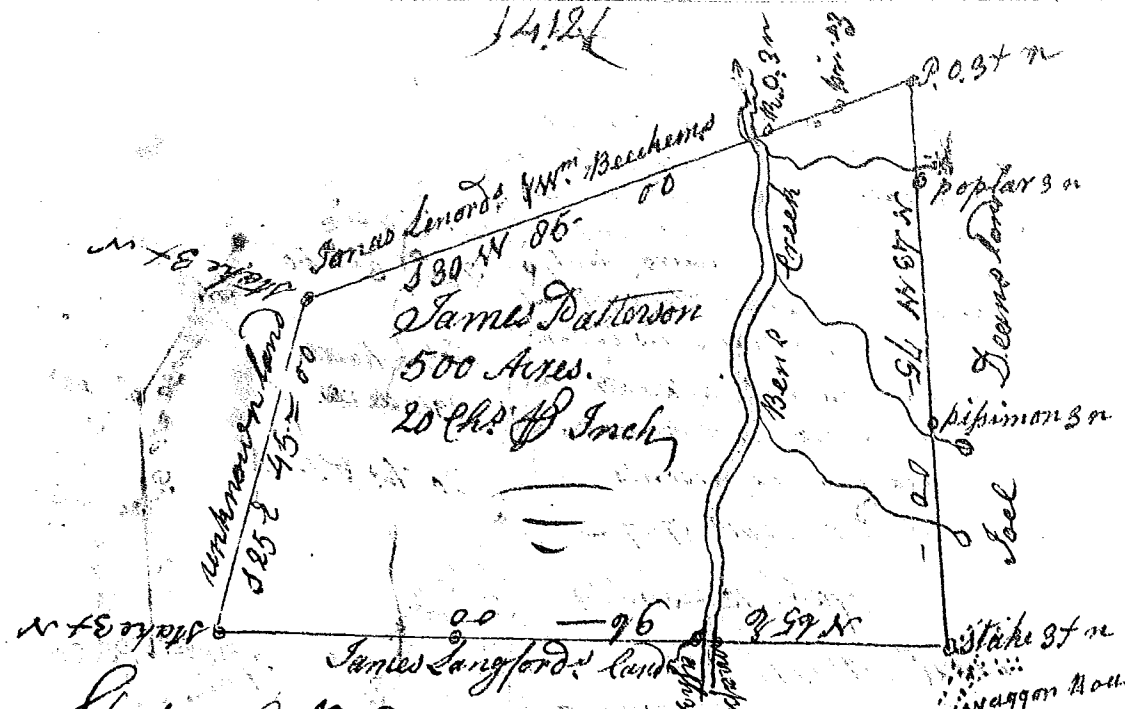

State of S^o Carolina — Pursuant to a warrant from John Thomas Com^r of Locations South of Saluda dated the 13th day of Septr 1797, I have measured & laid out unto James Patterson, a tract of five hundred acres of land, in Spartanburgh County & Pinckney District, between Enoree & Tyger Rivers on Bens creek Waters of Tyger River, bounded by lines running ~~N.W.~~ by land granted to Joel Deans N.E. by James Langfords land S.E. by unknown land S.W. by Jonas Leonards land & Wm. Beckhams, & hath such shape, marks, buttings & boundings as the above plat represents, Surveyd the 13th day of Septr 1797

Rec^d the 13th Septr 1797 & D^d Sepr James Kilgore D.S.

S^o Carolina/ Pursuant to a warrant from John Thomas Com^r of Loc^ns N. side Saluda river I have admeasured and laid out unto Hasm Walker a tract of thirty seven acres of land in pinkney District on the waters of Pacolat river, bounded by a line S.E. by land surveyd for Philip philpich N.E. by Mis Hendley's N.W. by said Hendley's land S.W. by land surveyd for Turner Kindrick, and hath such form and Marks as the above plat represents, Surveyd, 25 aug^t 1797. John Brown D.S.

Recorded 20 Septr 1797.

208
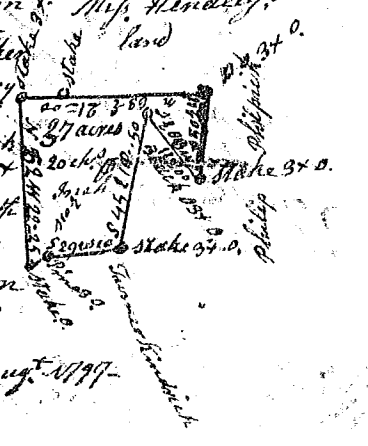
Date of warrant 23 aug^t 1797