

South Carolina) pursuant to (L 33)
a warrant from John Thomas Esq^r Com^t of Law^s

& side Saluda river dated 31st Augt 1797 -



= ney District Spartanburg County

on Bertars Creek waters of Pacolet

river bounded on all sides by land

said to be vacant, and hath

such shape and marks as the

annexed plat represents. —

S.W. W. 5th Sept^r 1797. —

Gab^r. Benson D^r.

Recorded 4th Oct^r 1797 —

South Carolina

Pursuant to a Warrant
from John Thomas Esq^r C^r

No^r of Saluda river; Dated the

7th July 1797 I have ad-

measured and laid out unto

Edward Ballinger a tract

of land containing two

Hundred of thirty two

acres, situated in the dis-

trict of Pinckney & County of

Spartanburgh, on Camp

branch of Lawson's fork waters

of Pacolet river, bounded

by a line running E by land

E. for Mr. Wood S E by land

Surveyd for Isham Foster N. E by


land S. E. unknown. N. W by land for Thomas Garvin

or on the other side by land Surveyd for Edward Ballinger

and hath such form & marks as the above plat represents.

Surveyd the 22nd July 1797

Recorded the 4th Oct^r 1797

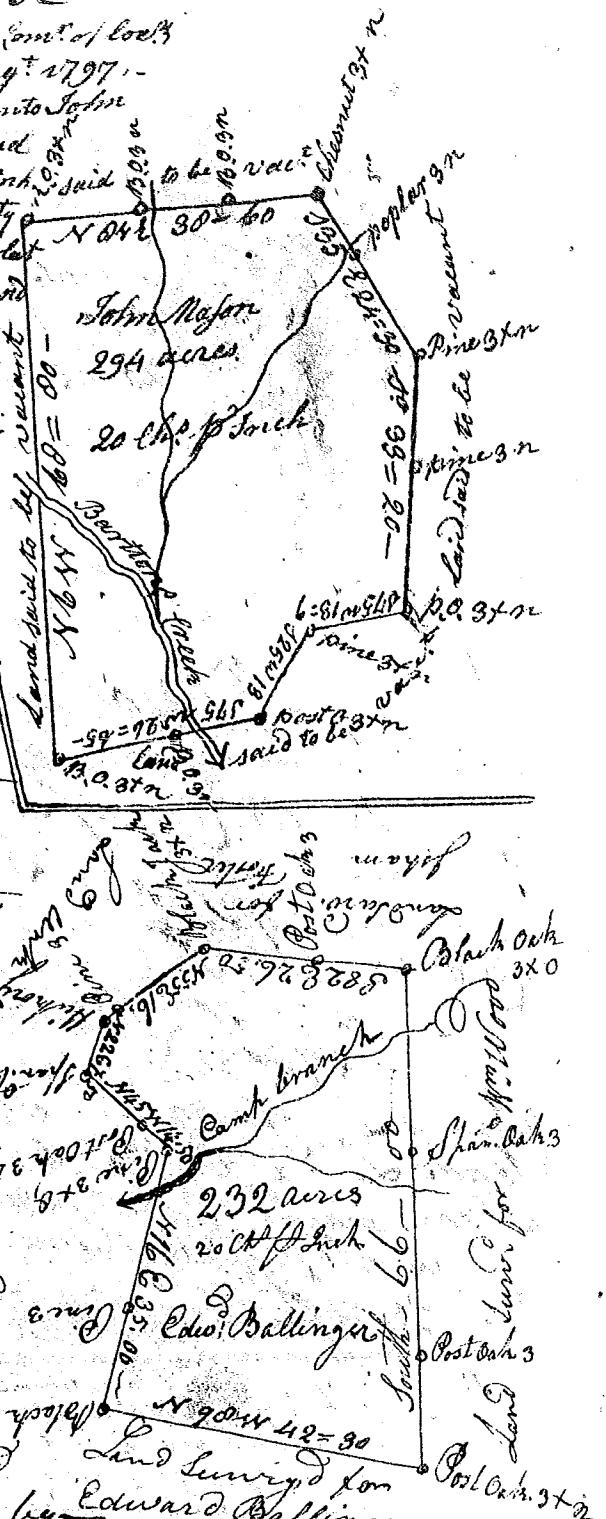

Gab^r. Benson D^r