


State of S. Carolina

Pursuant to a warrant from John Thomas Esq^r Com^t of Locations N^o. Saluda River. Bearing date the 26th March 1792 I have admeasured and laid out unto Hudson Barry a Tract of three hundred and seventy five acres of Land lying situated on the Branches of Beaver Dam and Derbins Creek in Laurens County Running S.E. with M^r Clarkens Land N.E. & S.E. with Travis's Land N.E. with John Cokers & Simpson's Land N.W. with Wilsons and S.W. & N.W. with Ratcliff Tools Land, all other Sides with Vacant Land and hath Such Shape and Marks as the above plat Represents.

Surveyed the 26th July 1792. James Wofford D.S.

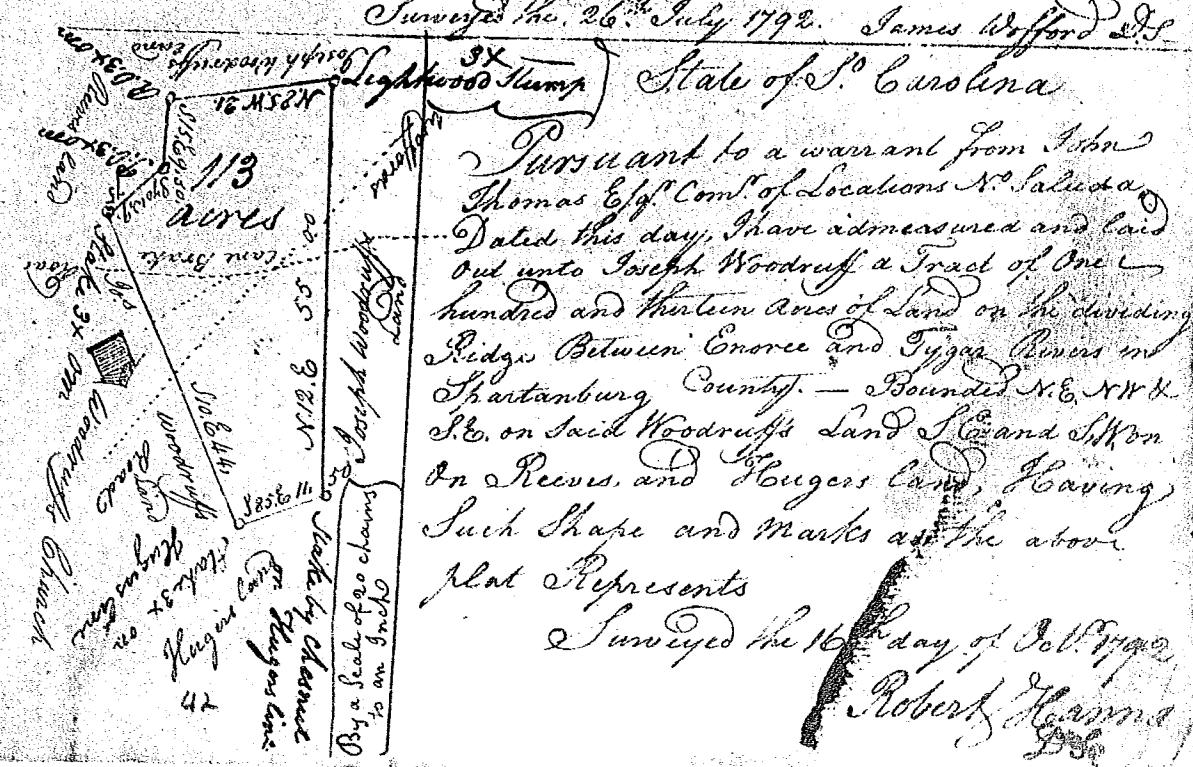

Pursuant to a warrant from John Thomas Esq^r Com^t of Locations N^o. Saluda River Dated this day, I have admeasured and laid out unto Joseph Woodruff a Tract of One hundred and Thirteen Acres of Land on the dividing Ridge Between Enoree and Tyger Rivers in Spartanburg County. — Bounded N.E. N.W. & S.E. on said Woodruff's Land S^t and S^t on Reeves, and Stingers Land, Having Such Shape and Marks as the above plat Represents.

Surveyed the 16th day of Oct. 1792,

Robert Harmer
D.S.