


S^t Carolina Pursuant to a warrant from John Thomas Esq^r
Comt of Locations N^o Saluda Dated the 17th day of January 1793
I have admeasured and laid Out unto John Boyse a Tract of three
hundred and seventeen acres of Land in Newbury County on a small
Branch of Pattersons Creek and Waters of Duncans Creek
Bounded S^t by land Surveyed for William Boyd Wth by land Sur-
veyed for Wm Scott & Robert Bates all other Sides by Robert
Bates & John Boyse's Land and hath such shape & Marks as
the above plat Represents Survey'd the 25th January 1793

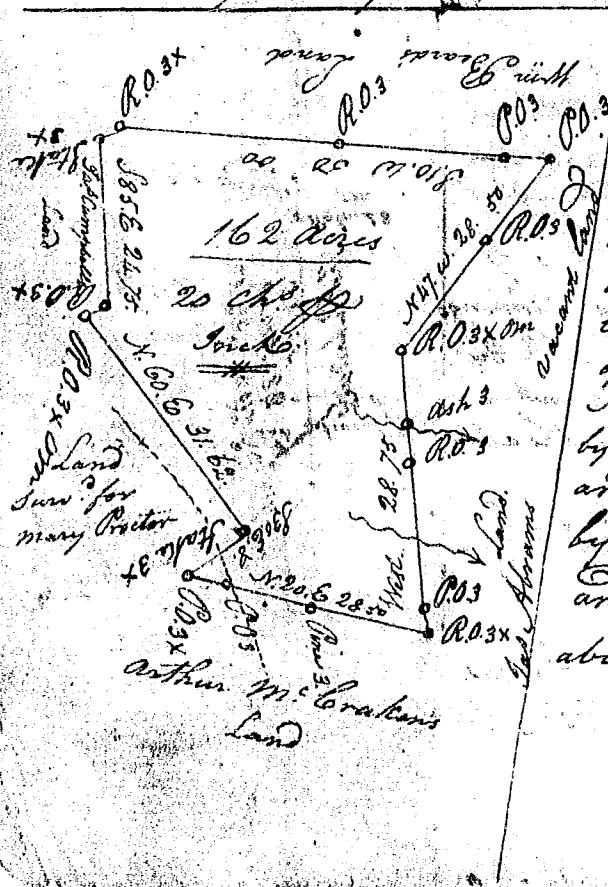

S^o Carolina Parson D^s

Pursuant to a warrant from John
Thomas Esq^r Com^t of Locations N^t Salida
dated the 19th day of January 1793. I have
admeasured & laid Out unto John Boyce
a Tract of One hundred & 62 acres of
land in Newbury County on the Draughts
of Duncans Creek bounded by a line running
N.E. by land Surveyed for Arthur M^r Crocker
by lines Running W. & N.W. by James Adams
and vacant land by a line Running S.W.
by James Campbell & Mary Proctors land
and hath such Shape & Marks as the
above plat Represents.

Surveyed the 22^d March 1793

A Pearson Dr