


South Carolina Pinckney District
 Pursuant to a warrant from John
 Thomas Com^r of Court N side Saluda
 dated 16th Sept. 1799, I have
 admeasured & laid out unto
 Samuel Jamison a tract of one
 hundred & eighteen acres of land



in Spartanburg County, on the Sth side
 of Sugar River running with land
 of E. with William Hendricks Sp. N. with land out
 Henry land N.E. with Michall B. Roberts & David Andersons lands
 all other sides with land out, and hath such shape and Marks
 as the above Plat represents, Survey. 19th Sept. 1799
 Recorded 4th Oct. 1799, De. self. J. James Wofford, D.S.

South Carolina
 Pursuant to a warrant
 from John Thomas Esq. Com.
 of Court N side Saluda
 dated 16th Oct. 1799, I
 have admeasured and laid
 out unto William Cobb
 a tract of eighty two acres of land
 on the waters of the Grove Creek of Saluda river, and
 hath such shape and Marks as the above Plat represents
 Survey. 19th Oct. 1799, William Bell D.S.
 Recorded 21st Oct. 1799, De. self.

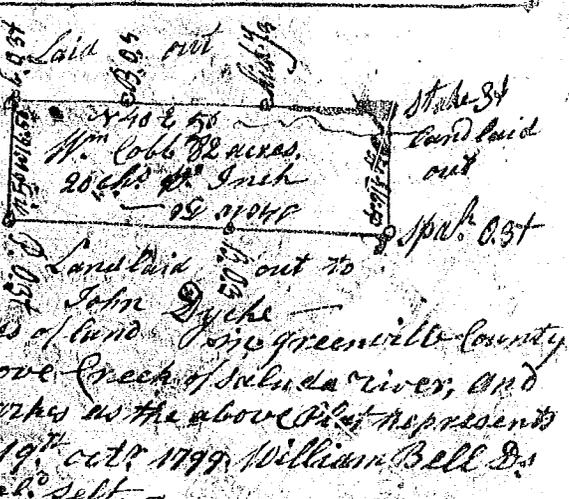

South Carolina, Pursuant to a warrant
 from John Thomas Com^r of Court N side of
 Saluda Dated 1st Oct. 1799, I have surveyed unto
 Mary Harrison a tract of 19 1/10 acres six fourths
 acres of land in Pinckney District Spartanburg
 County on the N.E. corner of Fairforest Creek
 bounded N by Mary Harrison's land, E by Golightly's
 land, S.W. on Wilkes land, & hath such shape, Marks, bearings &
 boundings as the above Plat represents, Survey. 5th Oct. 1799
 Recorded 21st Oct. 1799, J. Smith D.S.

