South Carolina

Pursuant to a Warrant from Wm D. Thomas, Com. Ld. in the district of Greenville, dated the 18th day of Nov. 1813. I have admeasured & laid out unto Isham Forrest, a tract of one hundred & Eighty Seven acres of land, Situate in said district, on both sides of South Tygar river: Bounded by a line running S.E. by land Surveyd for Richard Forrest, N.W. & N.E. by land Surveyd for Randolph Casey, N.W. & S.W. by grants land, S.W. by Wm Lynch's Land, & S.E. by Wm Wood's lands, & hath such form & marks as the above plat represents — Surveyd the 19th November 1813

Recorded 1st January 1814 Wm Cooke D.Sur

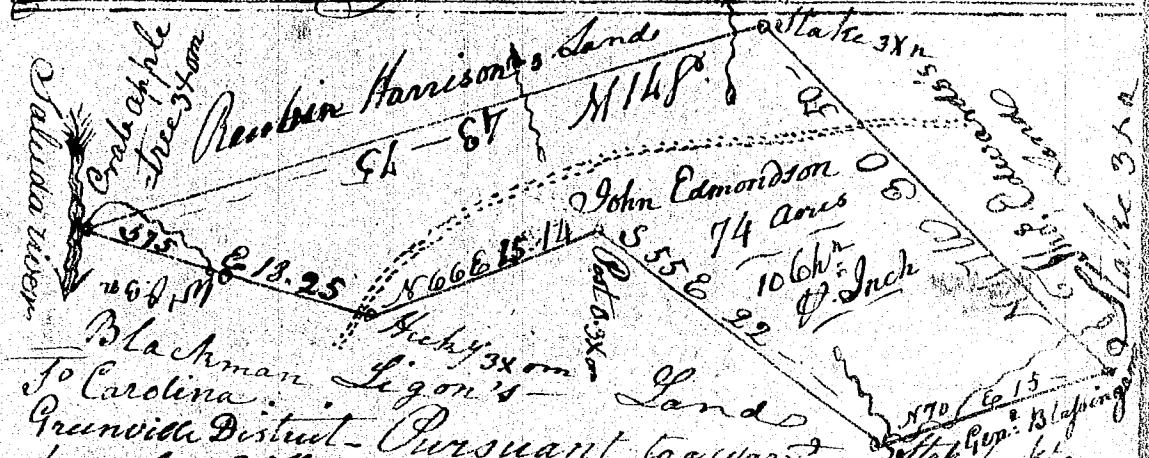

South Carolina — Greenville District — Pursuant to a warrt. from Wm D. Thomas Esq. C.L. dated the 12th day of January 1814 — I have admeasured & laid out unto John Edmondson a tract of Seventy four Acres, Situate in Greenville Dist. on the North side of Saluda river — Bounded to the South on Blackman, Legon's land & Genl. Blasingames. to the N.E. Thomas Edwards's to the N. on Reubin Harrison's lands, & West by Saluda river, & hath such shape form & marks as the above plat Represents — Surveyd the 14th Jany 1814

John Young D.S.

Recorded 27th Jany 1814 —