


Surveyed
and platted
for John Young

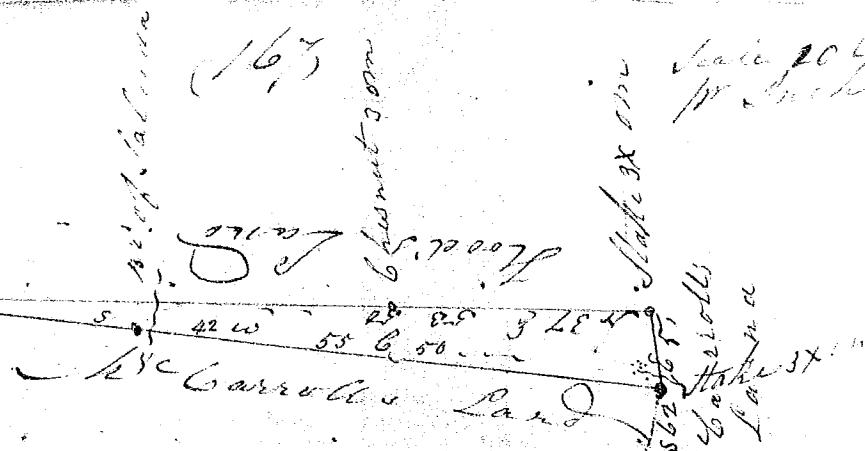

John Young
District Surveyor
Pursuant to a warrant from John
Young, Comr^r of Locations dated the 16th day
of March 1833, I have measured and laid
out unto Matthew Kelly a tract of land
containing thirteen and $\frac{1}{4}$ acres, situate in
said District on a branch of Saluda River
Running S 42 W on McCarroll's Land, thence S 62
on said McCarroll's Land, N 37 E on Hoods Land
and hath such marks and form as the above
plat represents.

Surveyed the 22nd day of March
1833 — L. G. Young, D.S.

Recorded the 10th day of April 1833, by
John Young, L.S.