


22739 Filed This 21<sup>st</sup> day of March 1971  
And Recorded in Vol. 41 Page 15 of 1971

*Ollie Farnsworth*

Register Meane Condyoned Greenville County, S. C.

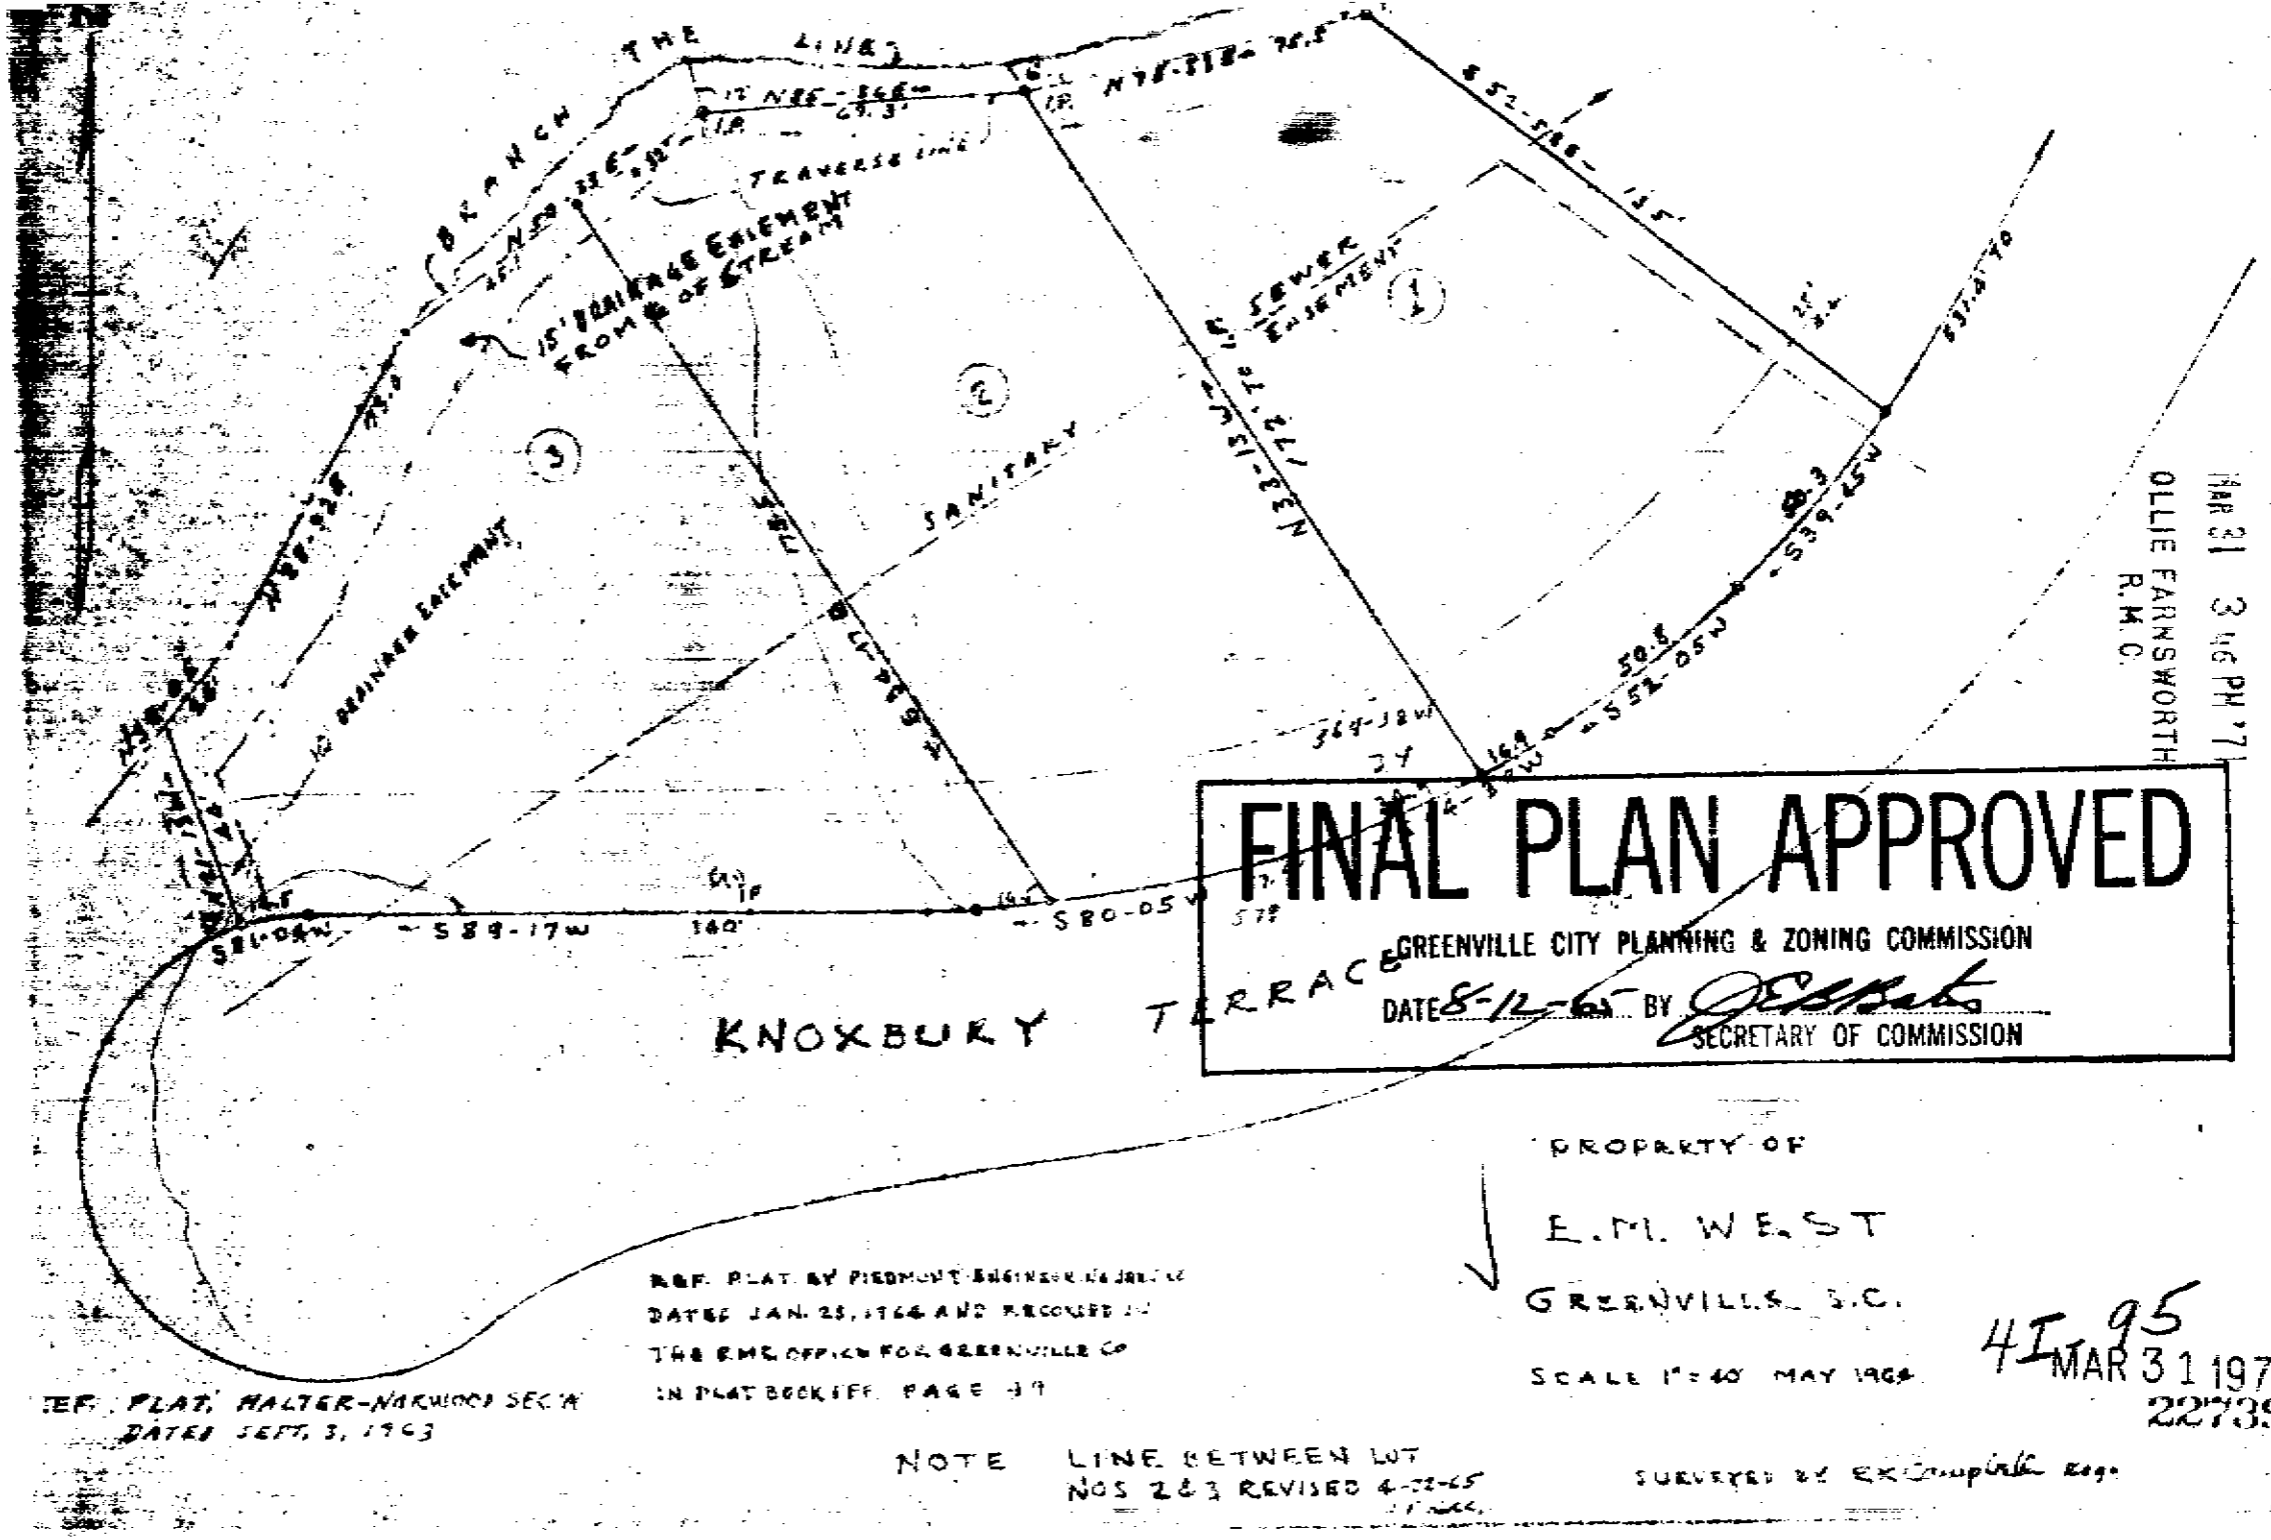

**FINAL PLAN APPROVED**  
 GREENVILLE CITY PLANNING & ZONING COMMISSION  
 DATE 8-12-65 BY *[Signature]*  
 SECRETARY OF COMMISSION

PROPERTY OF  
 E. M. WEST  
 GREENVILLE, S. C.  
 SCALE 1"=40' MAY 1968

REF. PLAT, HALTER-NORWOOD SEC. 14  
 DATED SEPT. 3, 1963

REF. PLAT. BY PIEDMONT ENGINEER & ARCHT.  
 DATED JAN. 25, 1966 AND RECORDED IN  
 THE REC. OFFICE FOR GREENVILLE CO  
 IN PLAT BOOK OFF. PAGE 39

NOTE LINE BETWEEN LOT  
 NOS 2 & 3 REVISED 4-22-65

SURVEYED BY *[Signature]*

4195  
 MAR 31 1971  
 22739

MAR 31 3 46 PM '71  
 OLLIE FARNSWORTH  
 R.M.O.

FILED  
 GREENVILLE CO. S. C.