Beginning at a nail & cap at the southeast intersection of Lindsay Avenue and Laurens Road (U. S. Hwy. 276), (P. O. B.), thence along Right-of-way of Lindsay Avenue N 35-06 E 188.6' to an iron pin joint front corner of Lot 88 and Lot 89, thence along joint line Lot 88 and Lot 89 S 55-45 E 150' to an iron pin in line of Lot 88 and rear corner of Lot 89, thence with joint line of Lots 89, 90, 96 & 97 S 35-06 W 188.6' to an iron pin on Right-of-way of Laurens Road, thence along Right-of-way of Laurens Road N 55-45 W 200' to the point of beginning.

LEGEND

B. C.	Bottom of Curb
T. C.	Top of Curb
G. W.	Guy Wire
G. V.	Gas Valve
F. H.	Fire Hydrant
P. P.	Power Pole
M. H.	Man Hole
S. W.	Side Walk
W. V.	Water Valve
N. & C.	Nail and Cap

CLOSURE

N	S	E	W
240.31	240.31	232.44	232.44

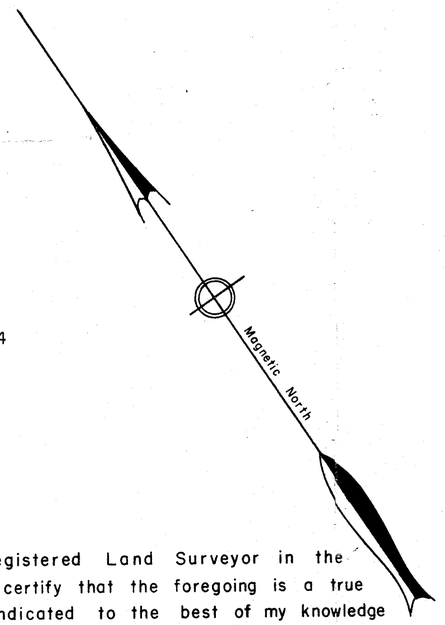

State of South Carolina
Greenville County

I, R. W. Dalton, a registered Land Surveyor in the State of South Carolina, hereby certify that the foregoing is a true and correct plat of the property indicated to the best of my knowledge and belief.

This the 21st day of December, 1970

R. W. Dalton

R. W. DALTON
S. C. Reg. No. 916

FILED
GREENVILLE CO. S. C.
JUL 3 3 39 PM '73
DONNIE S. TANKERSLEY
R.M.C.

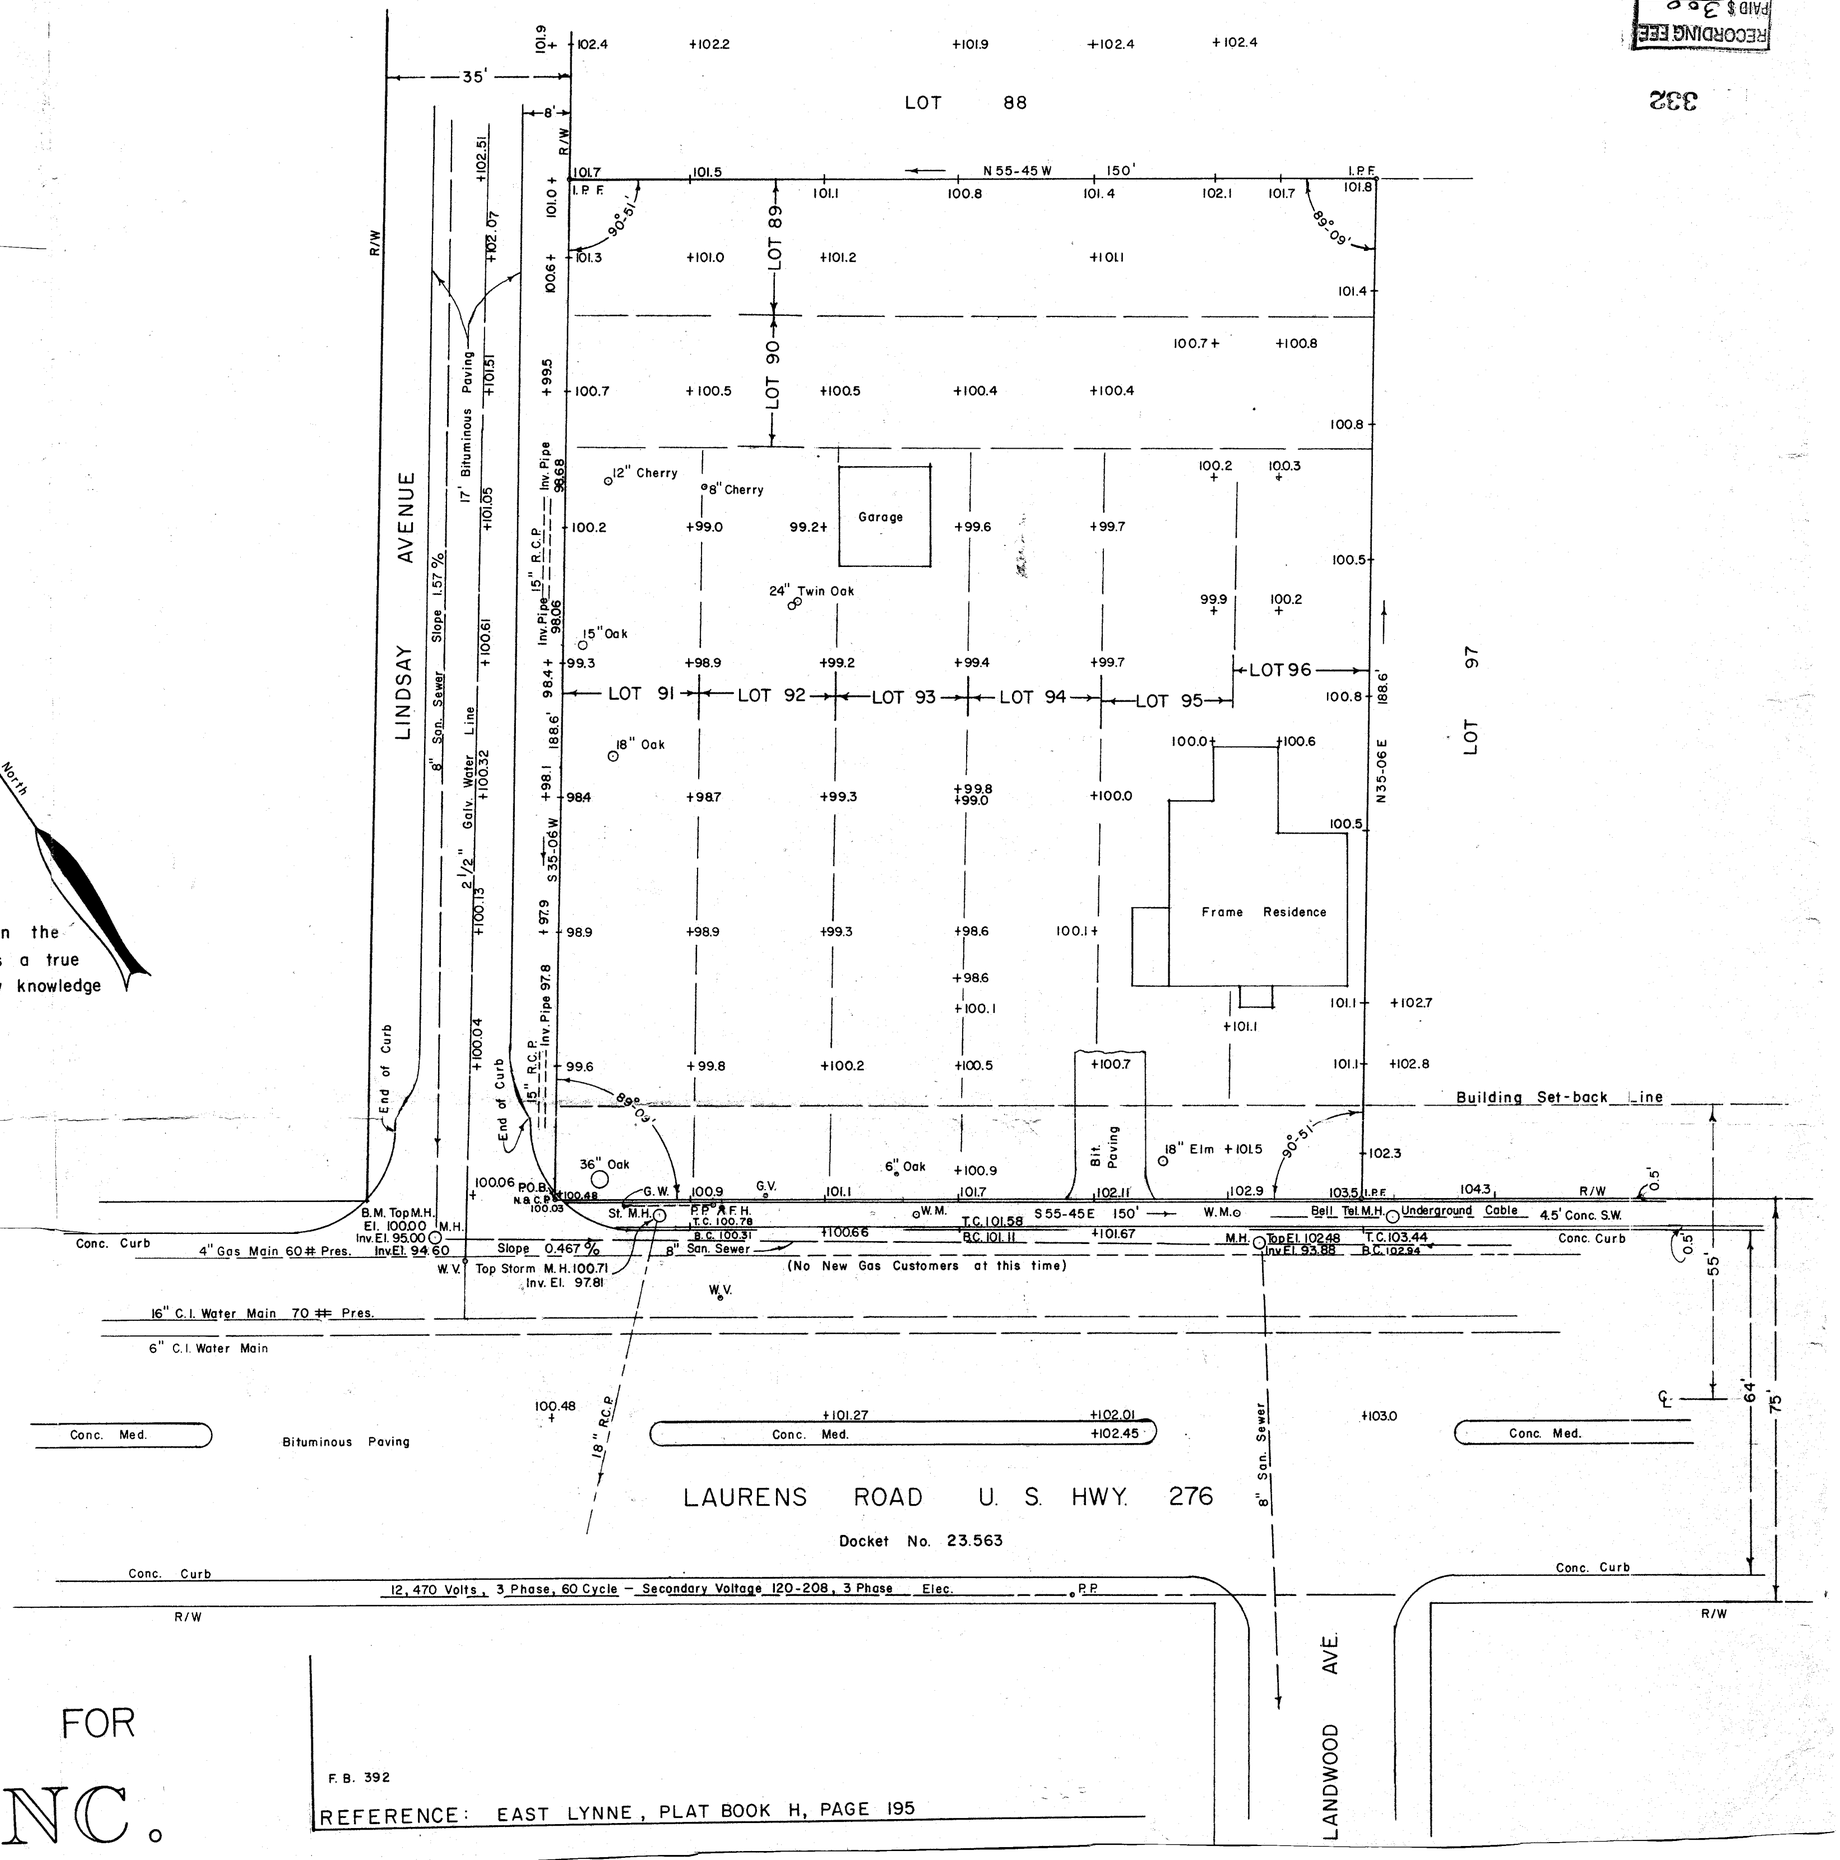

PROPERTY OF
4Z-50
L. E. McNAIR
GREENVILLE, S. C.
Scale 1" = 20' December, 1970
DALTON & NEVES, ENGINEERS
GREENVILLE, S. C.

TOPOGRAPHICAL SURVEY FOR
TEXACO, INC.

F. B. 392
REFERENCE: EAST LYNNE, PLAT BOOK H, PAGE 195

MICROFILMED
RECORDING FEE
PAID $ 3.00
332