

I.P. @ ALL CORNERS

MICROFILMED

S 41°-25' E 84.6'

PART LOT 75

PART LOT 75

PART LOT 76


LOT 74

LOT 76

N 52°-26' E 150.3'

S 51°-28' W 150.0'

OLD LOT LINES

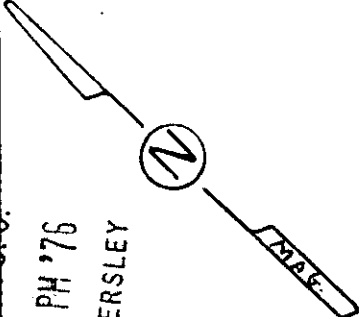

FILED  
GREENVILLE CO. S.C.  
JUL 6 3 46 PM '76  
DONNIE S. TANKERSLEY  
R.M.C.

WATER & SEWER IN ST. R/W

N 41°-25' W 87.2'

94.3' TO PADDOCK LANE

LONGSTREET DRIVE


This is to certify that on July 2, 1976, I surveyed the property shown on this plat, known as Part Lot 75 & 76 on plat of Devenger Place, Sec. I, recorded in the R.M.C. Office of Greenville County in Plat Book 4X on page 79, and that the property lines, walls and buildings are as shown hereon; that the building located on said lot does not encroach or project on adjacent streets or property, and that no adjacent walls or buildings encroach or project on said premises, and that no utility lines cross this property except as shown hereon.

JUL 6 1976

RECORDING FEE  
PAID \$ 1.00

520  
5-4-75

*James R. Freeland*  
James R. Freeland R.L.S. 4781

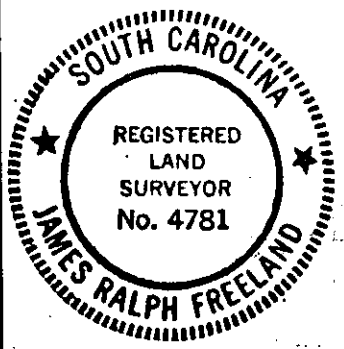

SEAL

**STATE OF SOUTH CAROLINA  
GREENVILLE COUNTY**

DEVENGER PLACE

SEC. I - PART LOT 75

PROPERTY OF

ALLYN PATRICK ROSE

KATHLEEN C. ROSE

FREELAND & ASSOCIATES  
Engineers • Land Surveyors

GREENVILLE, S. C.

SURVEY	JF
DRAWN	MC
CHECK	FL
SCALE	1" = 30'
DATE	7-2-76
DWG. NO.	76-1027