


Note: Improvements on this lot are not in a flood hazard area.

OCT 7 1983

PROPERTY OF
 KENNETH L. NORKETT, JR. & MARGARET S. NORKETT
 NEAR FOUNTAIN INN, GREENVILLE COUNTY, S.C.
 5 OCT 1983

✓ 10-B-59

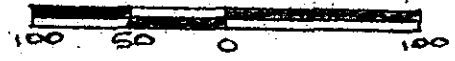

This is to certify that on the 5th day of October, 1983, I surveyed the property shown on this plat, being known as 2.81 acres on plat of PROPERTY OF JANIE ARMSTRONG and recorded in the RMC Office Greenville County, S. C., in Plat Book "4 - M." at Page 11 and also known as PROPERTY OF KENNETH L. NORKETT, JR. & MARGARET S. NORKETT recorded in Plat Book at Page ; and that the property lines, walls and buildings are as shown hereon, and that the walls and buildings located on said lot do not encroach or project on adjacent street or property, and that no adjacent walls or buildings encroach or project on said premises, and no power lines cross this property except as shown hereon.

11577

CAROLINA SURVEYING CO.
 112 Manly St.
 Greenville, S. C.

R. B. Bruce
 R. B. Bruce, RLS # 1952

RECORDER
 DONNIE S. AKERSLEY
 R.M.C.
 OCT 7 10 37 AM '83
 GREENVILLE CO. S.C.
 FILED

RECORDED
 10 11 AM '83
 GREENVILLE CO. S.C.

3.00 8 31801