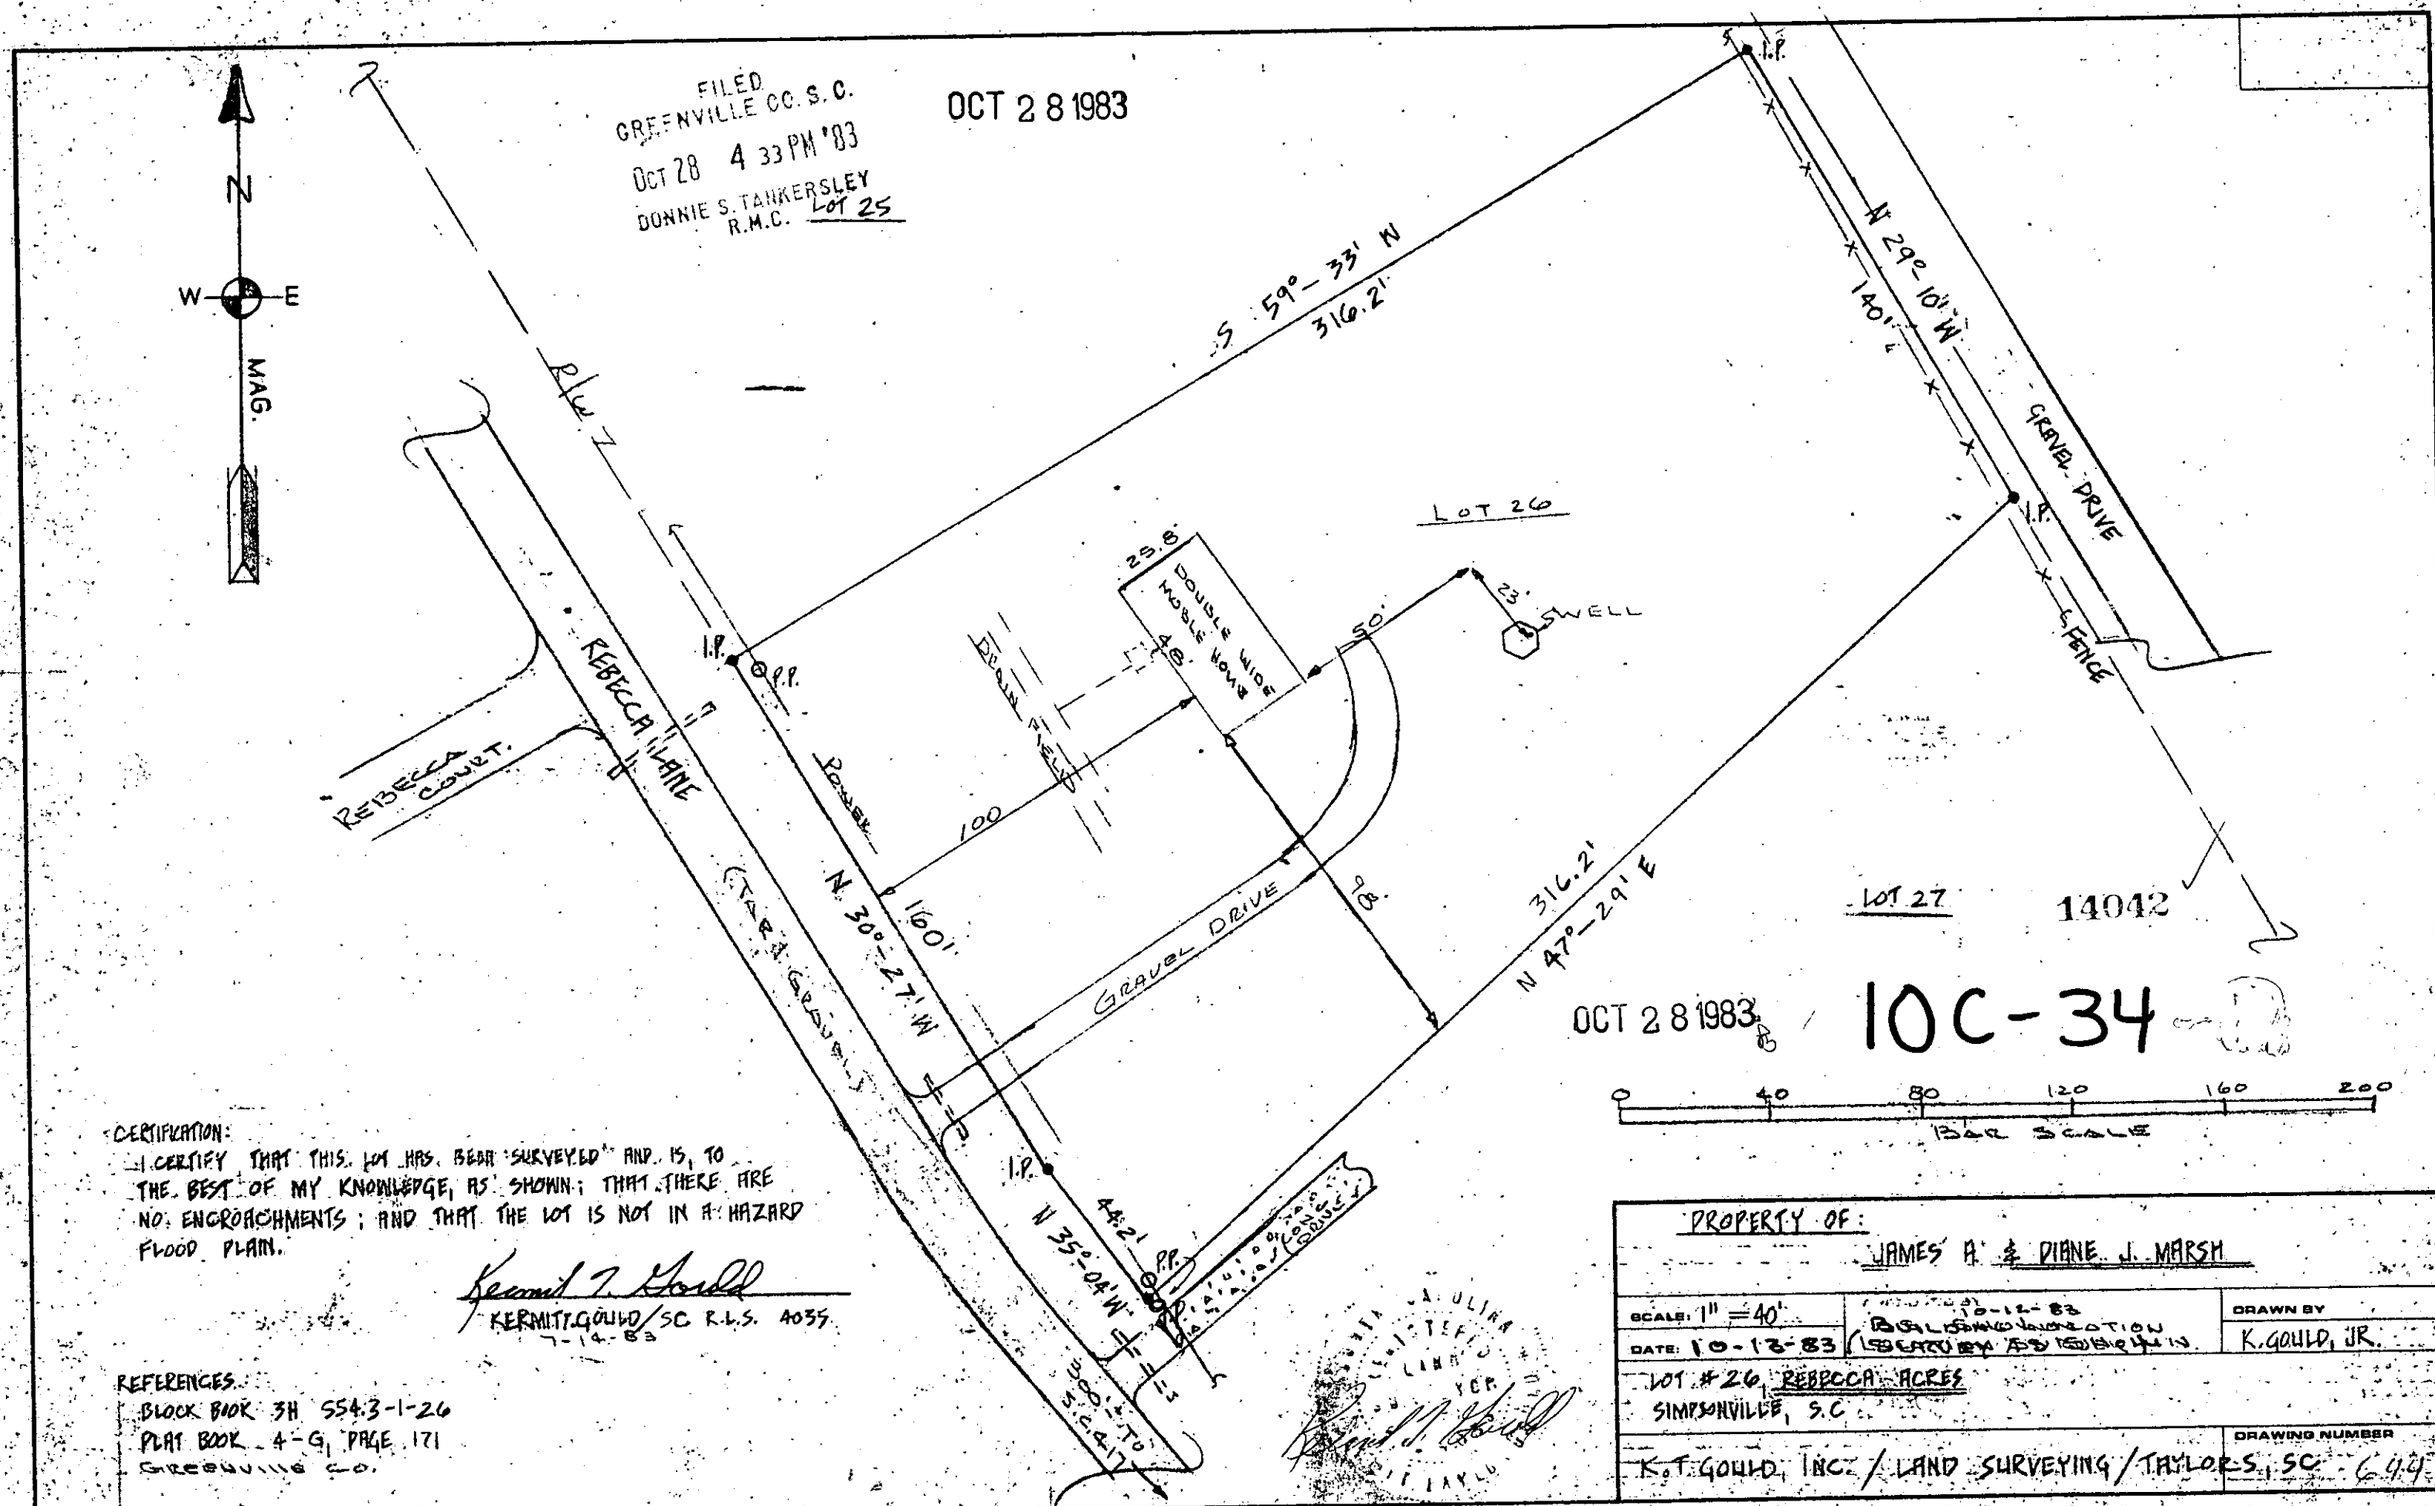

CERTIFICATION:
I CERTIFY THAT THIS LOT HAS BEEN SURVEYED AND IS, TO THE BEST OF MY KNOWLEDGE, AS SHOWN; THAT THERE ARE NO ENCROACHMENTS; AND THAT THE LOT IS NOT IN A HAZARD FLOOD PLAIN.

Kermit T. Gould
KERMIT T. GOULD/SC R.L.S. 4035
7-14-83

REFERENCES:
BLOCK BOOK 3H 554.3-1-26
PLAT BOOK 4-G, PAGE 171
GREENVILLE CO.

PROPERTY OF:
JAMES A. & DIANE J. MARSH

SCALE: 1" = 40'	10-12-83 BUILDING LOCATION SURVEY AS SHOWN	DRAWN BY
DATE: 10-13-83		K. GOULD, JR.
LOT #26, REBECCA ACRES SIMPSONVILLE, S.C.		
K.T. GOULD, INC. / LAND SURVEYING / TAYLORS, SC		DRAWING NUMBER 644

MICROFILMED

DIETZGEN NO 186MF AGEPROOF MASTER FORM

5.00CI