
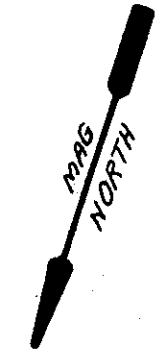
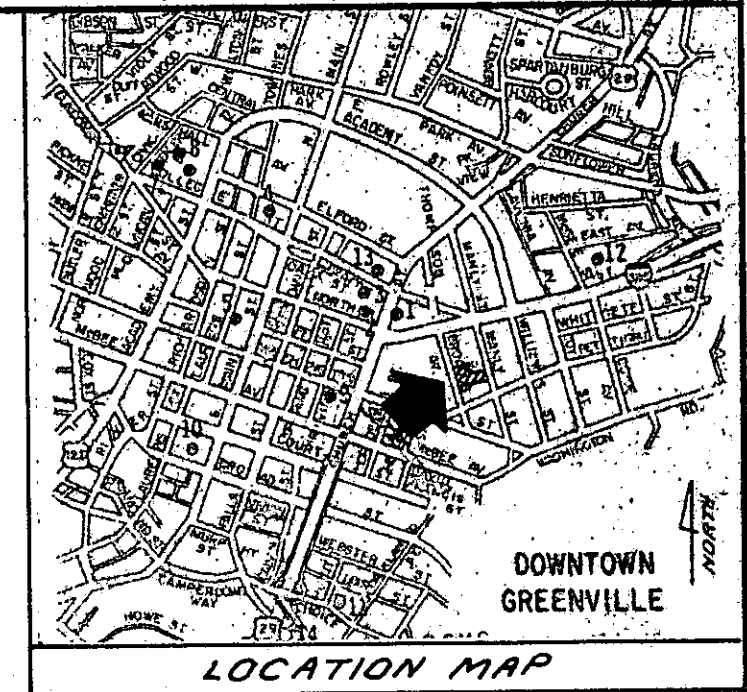


FILED
GREENVILLE CO. S.C.
Nov 22 9 16 AM '83
DONNIE S. TANKERSLEY
R.M.C.

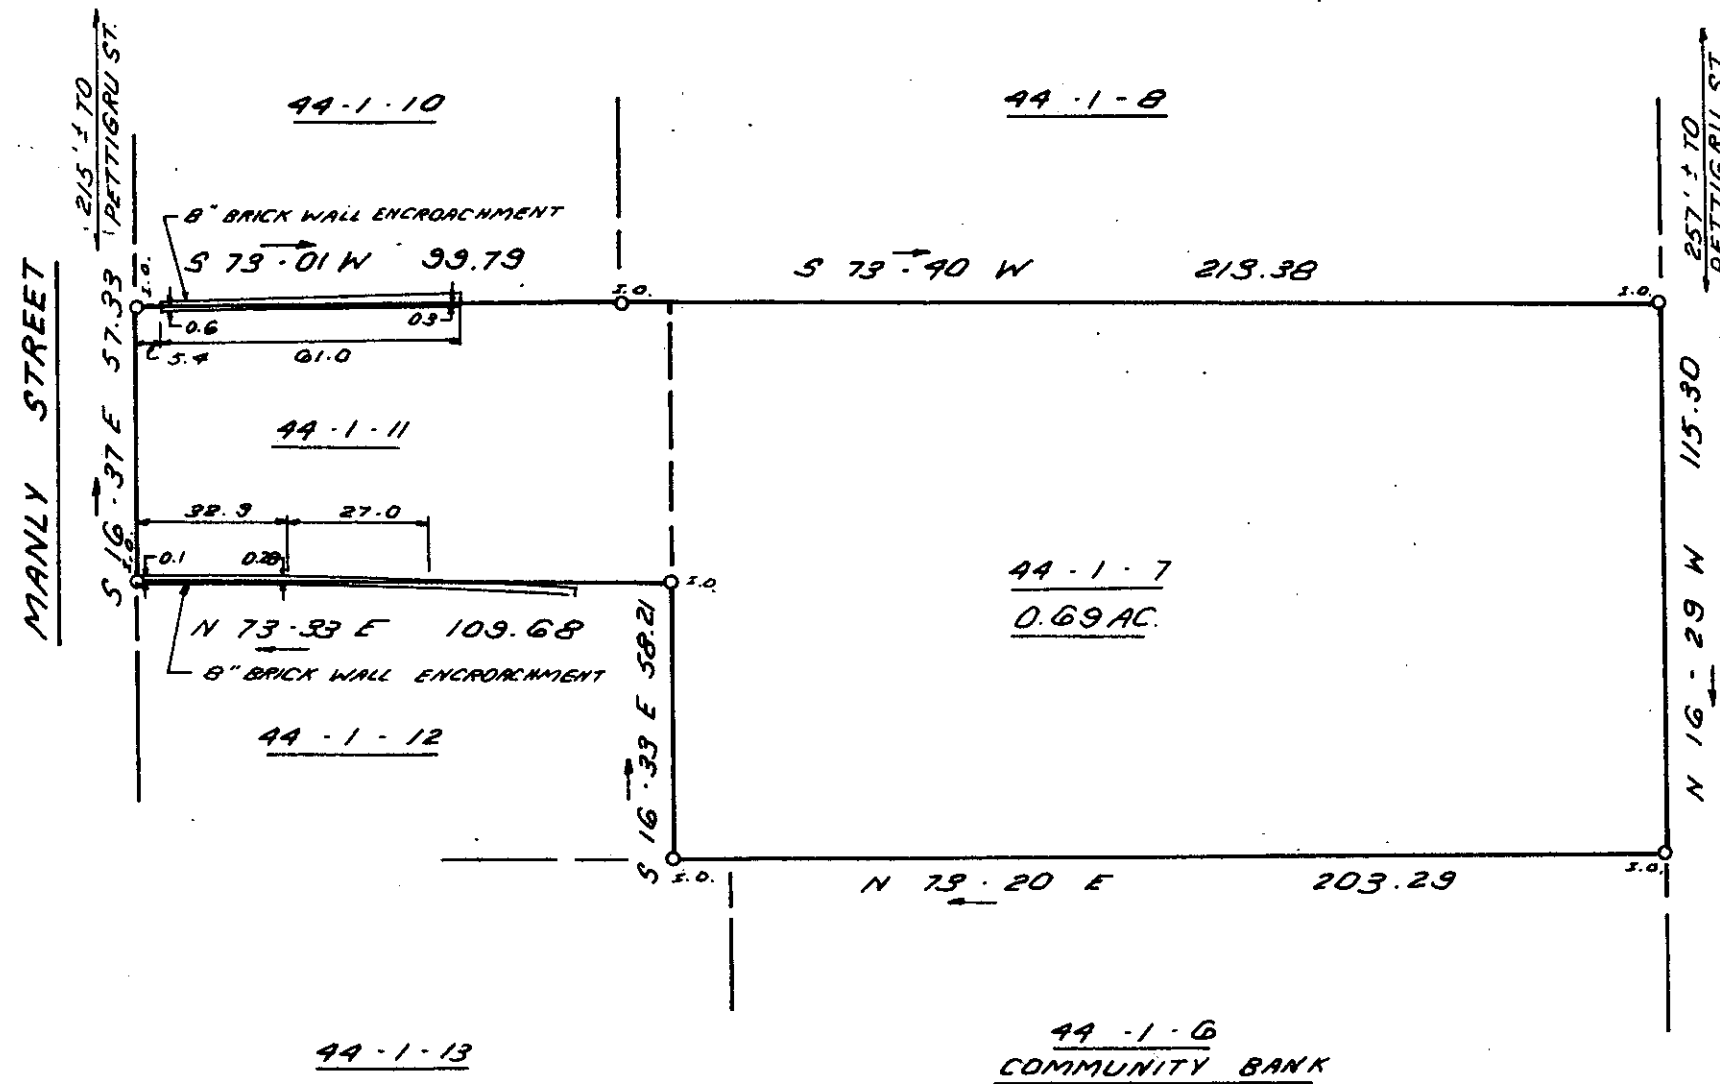


NOV 22 1983

I hereby certify that the ratio of precision of the field survey is 1/5,000 as shown hereon and the area was determined by DMD Method.

James R. Freeland
James R. Freeland RLS & PE 4781 16611 ✓

10-C-86

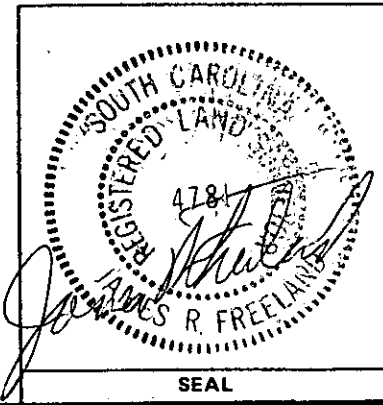

STATE OF SOUTH CAROLINA
GREENVILLE COUNTY

SURVEY FOR
FACILITIES PLANNING
INCORPORATED

FREELAND & ASSOCIATES
Engineers • Land Surveyors
GREENVILLE, S.C.

SURVEY	F.E.L.
DRAWN	K.E.G.
CHECK	M.L.C.
SCALE	1" = 40'
DATE	10-27-83
DWG. NO.	9949

MICROFILMED