MICROFILMED

Recordable Plat

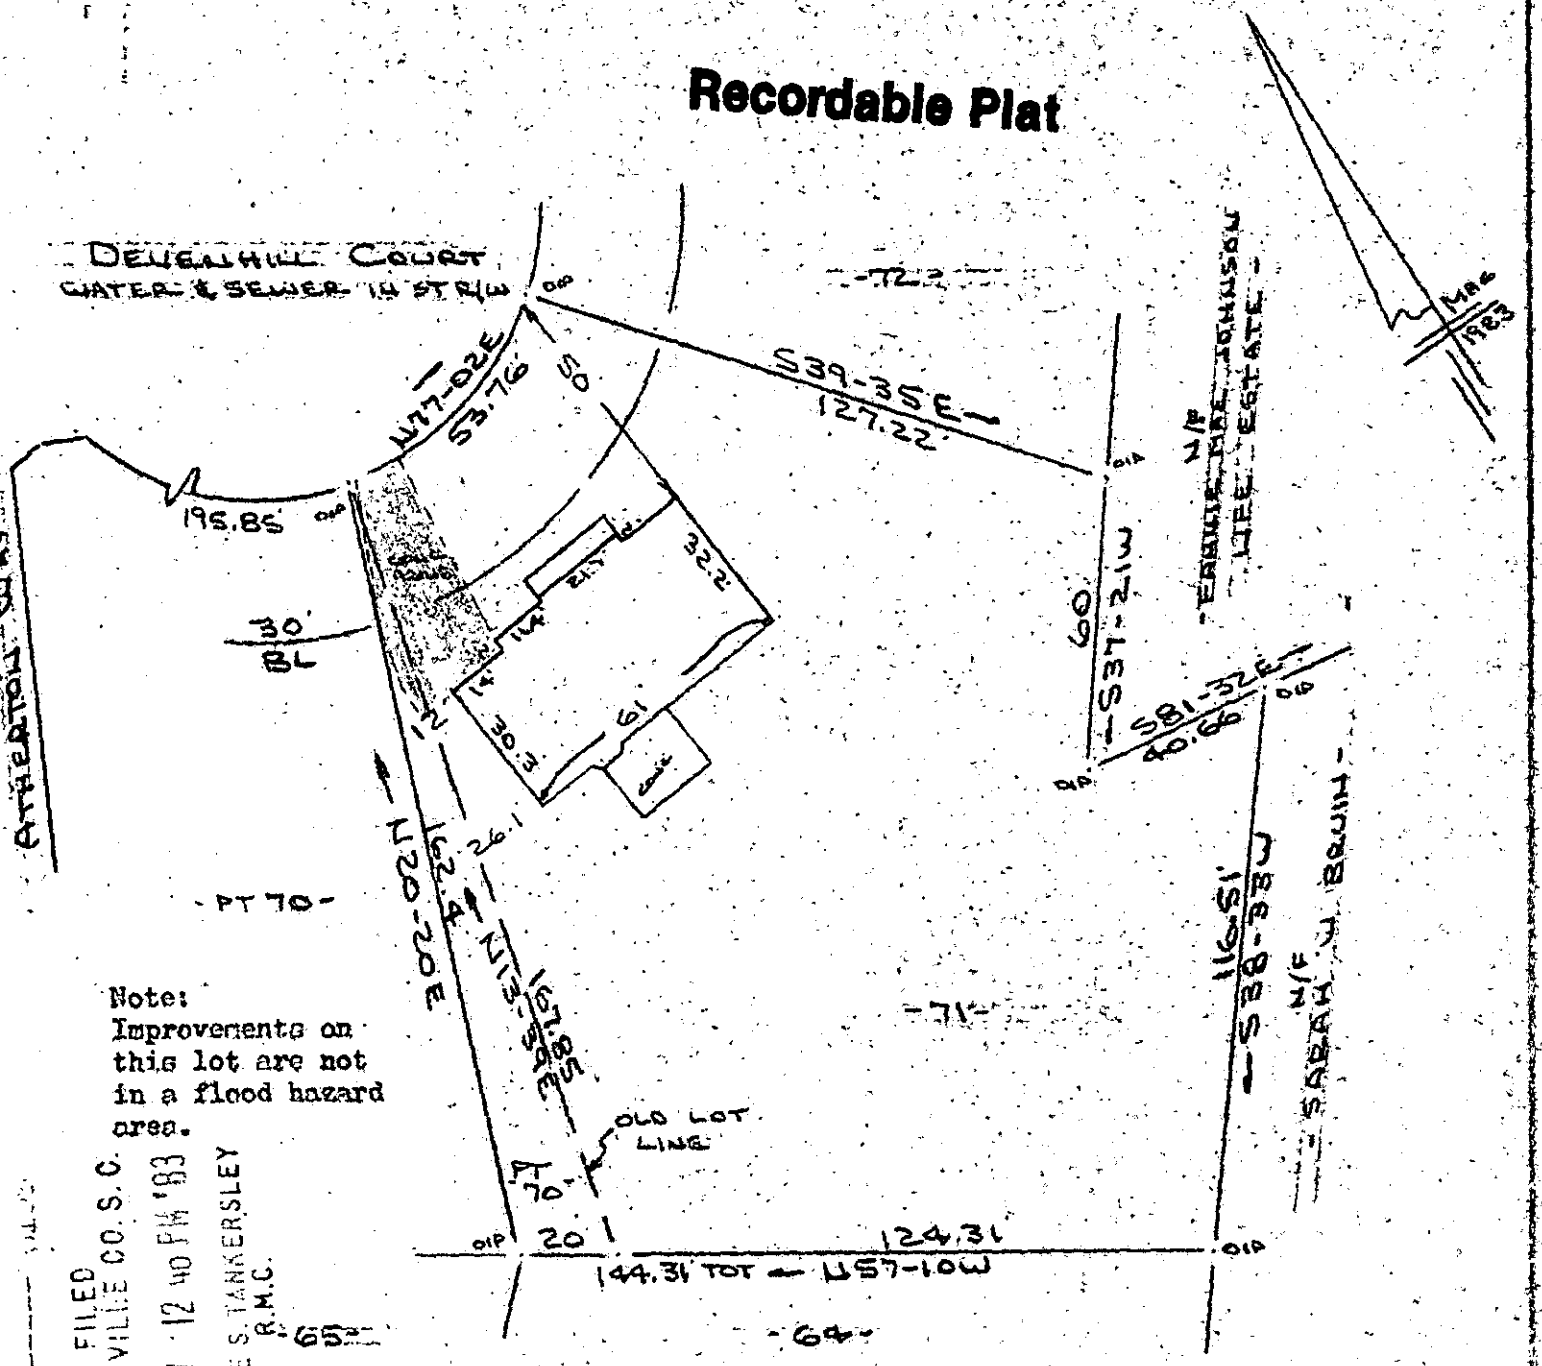

FILED
GREENVILLE CO. S. C.
OCT 27 12 40 PM '83
CONNIE S. TANKERSLEY
R.M.C.

OCT 27 1983

13800

10-D-42

This is to certify that on the 11th day of October, 1983, I surveyed the property shown on this plat, being known as lot 71 & pt. 70 on plat of SECTION ONE DEVELOPER POINTE and recorded in the RMC Office Greenville County, S. C., in Plat Book " 9-F " at Page 59; and that the property lines, walls and buildings are as shown hereon, and that the walls and buildings located on said lot do not encroach or project on adjacent street or property, and that no adjacent walls or buildings encroach or project on said premises, and no power lines cross this property except as shown hereon. Also known as PROPERTY OF GREGORY LEON KAZIAN & ELLEN L. KAZIAN and recorded in Plat Book at Page

OCT 27 1983

R. B. Bruce, RLS 1952

CAROLINA SURVEYING CO., 112 Manly St., Greenville, S. C.

OCT 27 2 00 PM 83 1440

3.00CI