



MICROFILMED

Note: Improvements on this lot are not in a flood hazard area.

FILED GREENVILLE CO. S. C.
OCT 31 1 08 PM '83
DONNIE S. TANKERSLEY
R.M.C.

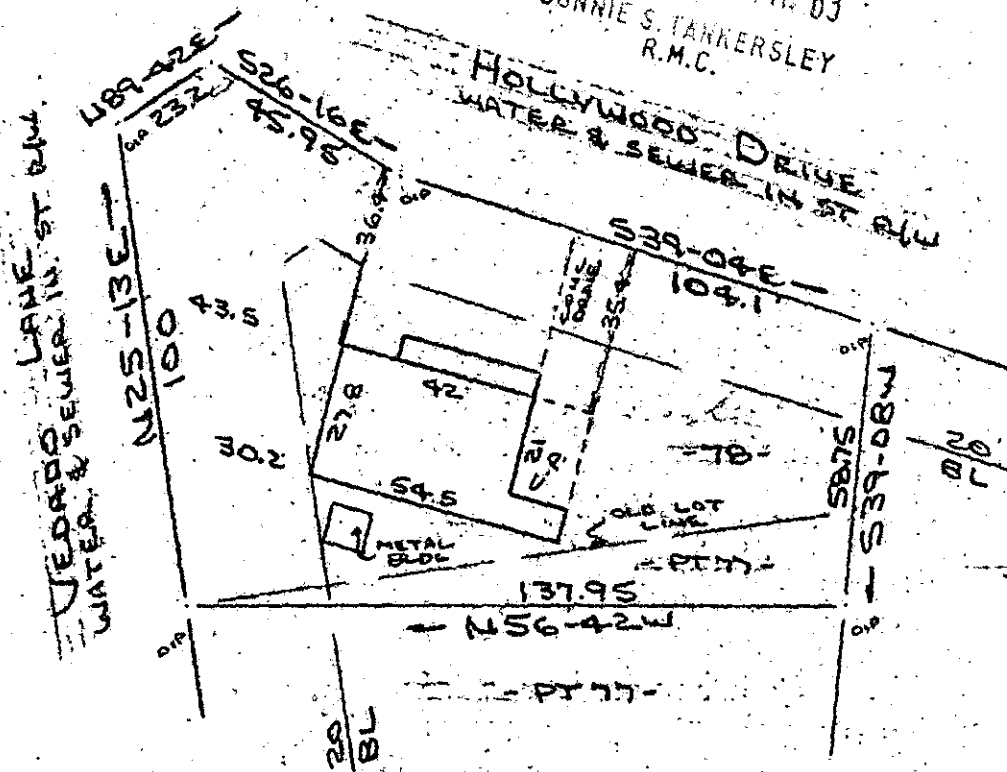

PROPERTY OF
JOSEPH E. JONES, JR. & LORETTA Y. JONES
NEAR GREENVILLE, S.C.
5 OCT 1983

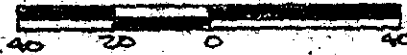

This is to certify that on the 5th day of October, 1983, I surveyed the property shown on this plat, being known as lot 78 and part of lot 77 on plat of REVISION LOT 78 - SECTION 1 & LOT 77 - SECTION 2 and recorded in the RMC Office Greenville County, S. C., in Plat Book " 4 - D " at Page 9; and that the property lines, walls and buildings are as shown hereon, and that the walls and buildings located on said lot do not encroach or project on adjacent street or property, and that no adjacent walls or buildings encroach or project on said premises, and no power lines cross this property except as shown hereon.

14208

OCT 31 1983

10-D-58 R. B. Bruce

R. B. Bruce, RLS 71952

Recordable Plat

CAROLINA SURVEYING CO.
112 Holly St.
Greenville, S. C.



0010 0028 83 017 3.0000