

This is to certify that on November 15, 1983, I surveyed the property shown on this plat, known as Lots 51, 52, and 53 on Plat of Avalon Estates, recorded in the RMC Office of Greenville County in Plat Book 9 on Page 89, and that the property lines, walls and buildings are as shown hereon; that the building located on said lot does not encroach or project on adjacent streets or property, and that no adjacent walls or buildings encroach or project on said premises, and that no utility lines cross this property except as shown hereon. This property is not located in a designated flood hazard area.

NOV 21 1983

NOV 21 1983

James R. Freeland
James R. Freeland RLS & LE 4781

16406

10-E-14




STATE OF SOUTH CAROLINA
GREENVILLE COUNTY

FREELAND & ASSOCIATES
Engineers • Land Surveyors

GREENVILLE, S.C.

AVALON ESTATES
LOTS 51, 52 & 53
PROPERTY OF
WILLIAM P. OWENS
NANCY B. OWENS

| | |
|----------|----------|
| SURVEY | J.C. |
| DRAWN | K.E.G. |
| CHECK | M.C. |
| SCALE | 1" = 40' |
| DATE | 11-15-83 |
| DWG. NO. | 10049 |

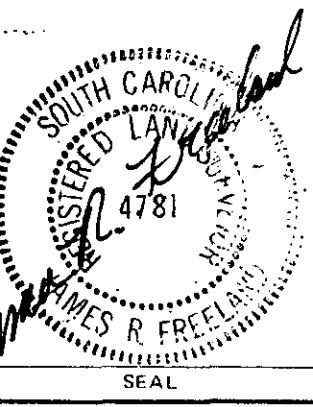

30001 THE PRINT MACHINE, INC. N30331
 2 NO 22 83