



This is to ce<u>rtify that on Not, 9,1983.</u> I surveyed the property shown on this plat recorded in the R.M.C. Preenville County in Plat Book 4N, page 7/ known as Lot 58, Section 1 of Forrester woods Subdivision; and that all property lines, walls, and buildings are as shown hereon, that the buildings on said lot do not encroach or project on adjacent streets or property, and that no adjacent walls or buildings

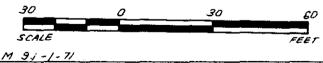

encroach or project on said premises, and that no utility lines cross this property except service lines unless shown hereon. This property is not located in a designated flood plain.

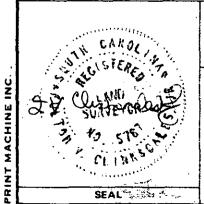

STATE OF SOUTH CAROLINA GREENVILLE COUNTY

FORRESTER WOODS

SEC. 1; LOT 58

PROPERTY OF

JOHN C. MITCHELL

BETFOTO MITCHELL

85

FREELAND & ASSOCIATES

Engineers . Land Surveyors

GREENVILLE, S.C.

	SURVEY D.W.
	DRAWN B.R.
	CHECK FIC.
	SCALE / = 30'
	DATE NOV. 9, 1983
048	DWG. NO. 4 2045 0000