


-41- -42- -43-

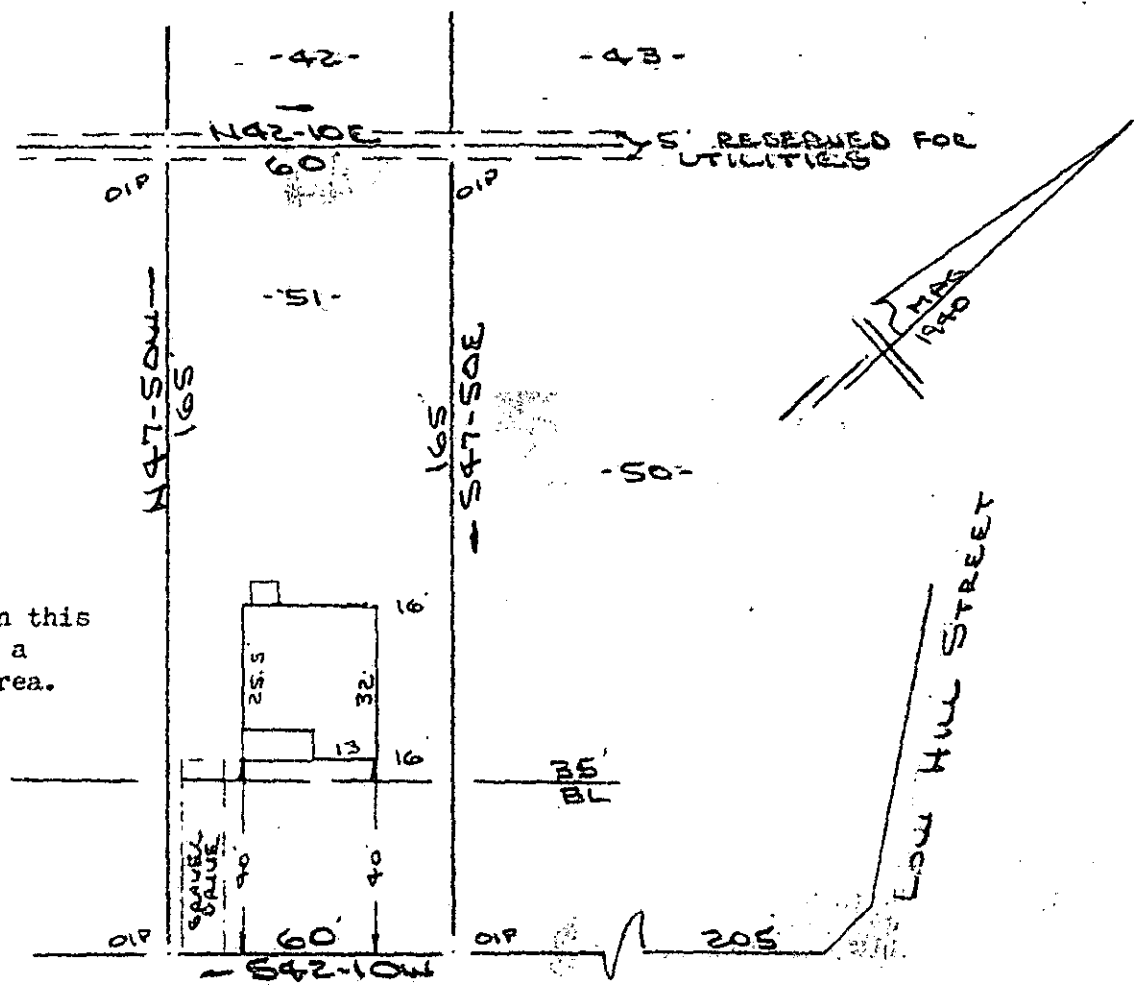


Note:
Improvements on this lot are not in a flood hazard area.

WATER & SEWER IN ST. 21/4

FILED
GREENVILLE CO. S.C.
NOV 29 2 34 PM '83
JUNNIE S. TARKERSLEY
R.M.C.

PROPERTY OF
STAVO FERNANDEZ RUBIO & BELINDA K. RUBIO
GREENVILLE, S.C.
22 NOV 1983

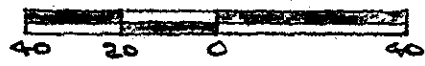

This is to certify that on the 22nd day of November, 1983, I surveyed the property shown on this plat, being known as lot 51 on plat of AUGUSTA ROAD HILLS and recorded in the RMC Office Greenville County, S. C., in Plat Book " L " at Pages 56 & 57; and that the property lines, walls and buildings are as shown hereon, and that the walls and buildings located on said lot do not encroach or project on adjacent street or property, and that no adjacent walls or buildings encroach or project on said premises, and no power lines cross this property except as shown hereon.

10-E 42 NOV 29 1983

R. Bruce
R. Bruce, RES #1952
NOV 1983
LAND SURVEYOR

CAROLINA SURVEYING CO.
112 Manly St.
Greenville, S. C.

SC70 -- 1 N029 83 036 3.0001