MICROFILMED

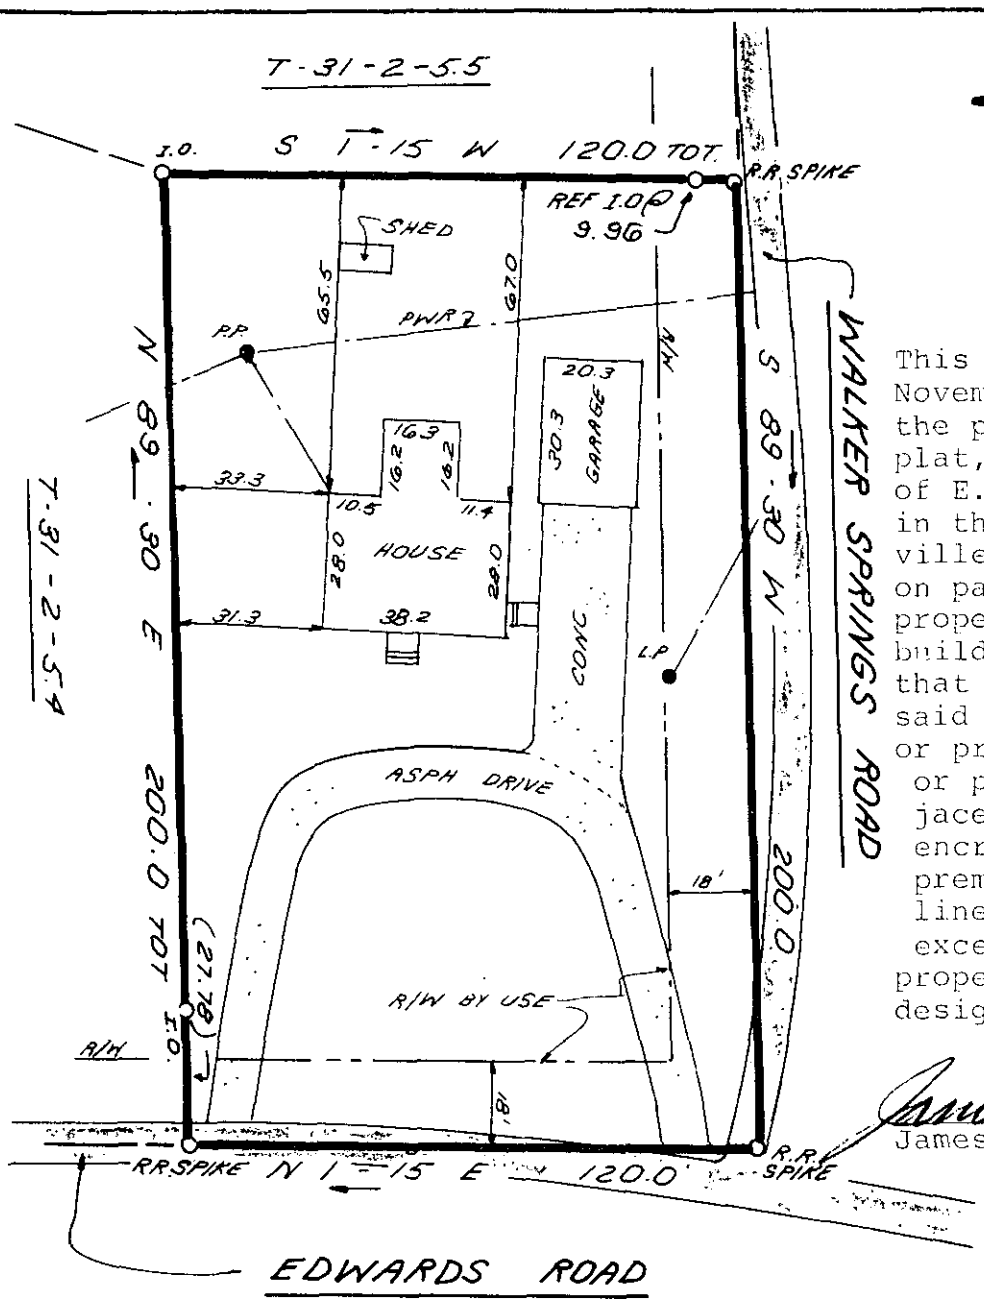


This is to certify that on November 26, 1983, I surveyed the property shown on this plat, known as the property of E.M. Whitmire, recorded in the RMC Office of Greenville County in Deed Book 324 on page 468 and that the property lines, walls and buildings are as shown hereon; that the building located on said lot does not encroach or project on adjacent streets or property and that no adjacent walls or buildings encroach or project on said premises, and that no utility lines cross this property except as shown hereon. This property is not located in a designated flood hazard area.

James R. Freeland

James R. Freeland PE and RLS 4781

FILED
GREENVILLE CO. S.C.
DEC 1 10 15 AM '83
DONNIE S. TANKERSLEY
R.M.C.

17678

10-E-47

40 0 40 80
SCALE FEET

REF TAX BLK. BK. T-31-2-4

SOUTH CAROLINA REGISTERED LAND SURVEYOR 4781 JAMES R. FREELAND

SEAL

**STATE OF SOUTH CAROLINA**
**GREENVILLE COUNTY**

SURVEY FOR

JAMES CECIL SULLINS
MICHELE SHAVER SULLINS

FREELAND & ASSOCIATES
*Engineers • Land Surveyors*

GREENVILLE, S.C.

| | |
|---|---|
| SURVEY | J.E.C. |
| DRAWN | K.E.G. |
| CHECK | M.C. |
| SCALE | 1"=40' |
| DATE | 11-26-83 |
| DWG. NO. | 10127 |

3.00 8 3180