


MICROFILMED

MARUE DRIVE (MILLS AVENUE)  
WATER & SEWER IN ST DW

N71-22E - 230.2 TOT

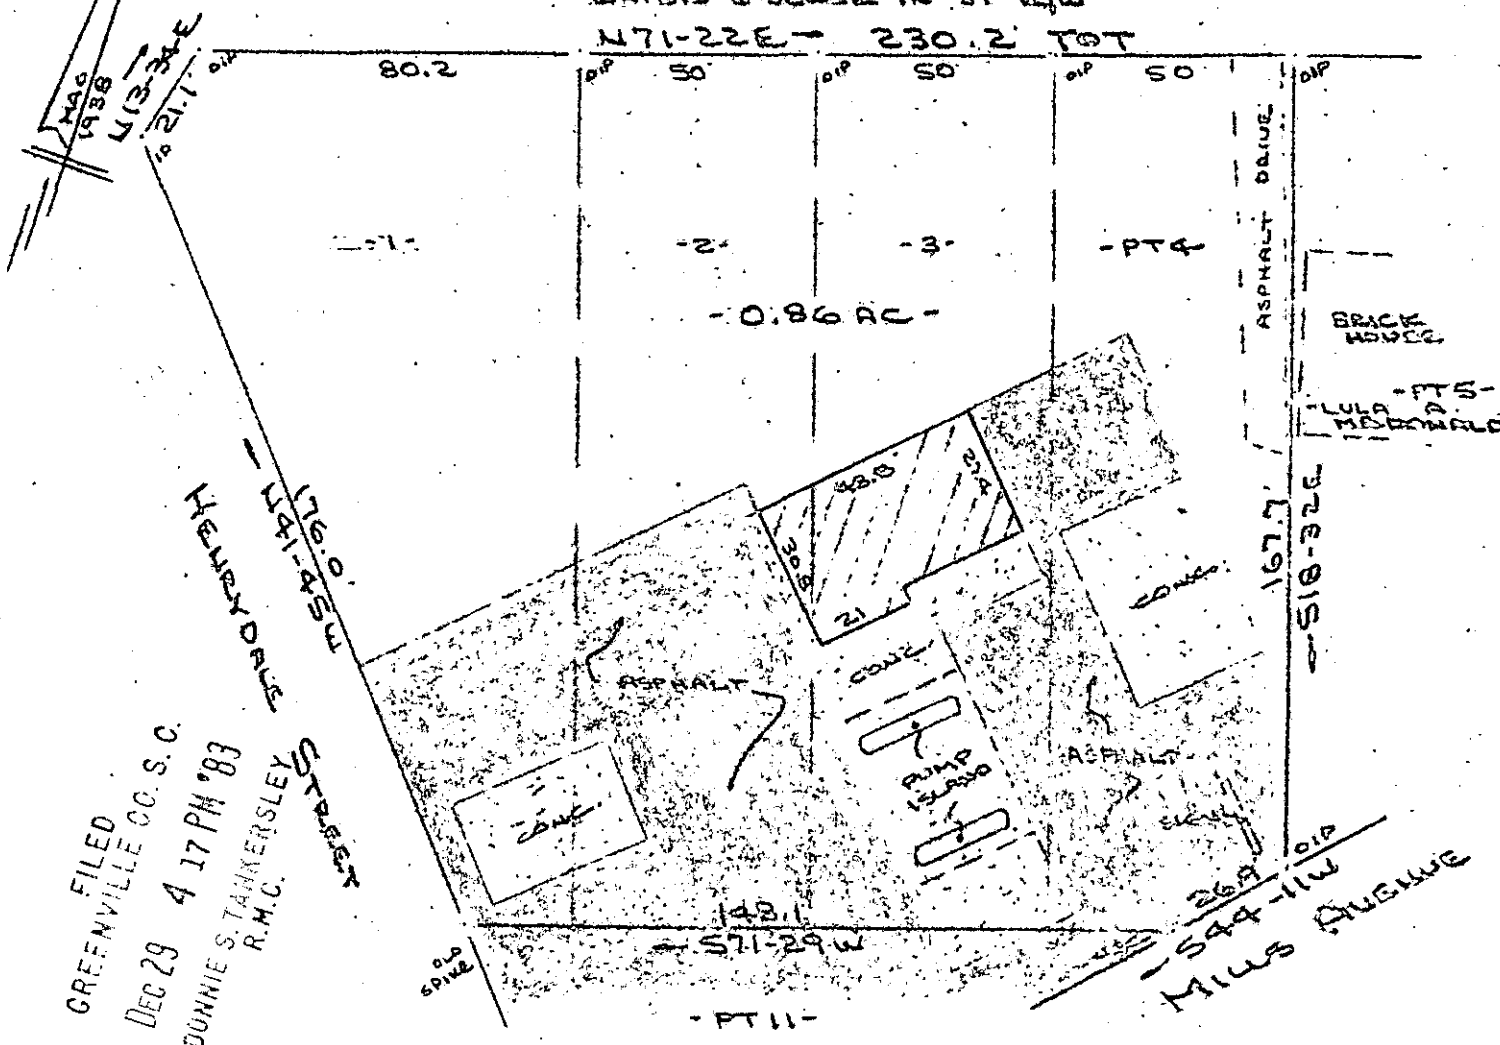


FILED  
GREENVILLE CO. S. C.  
DEC 29 4 17 PM '83  
DONNIE S. TANKERSLEY  
R.M.C.

SURVEY FOR  
DAVID M. PRESTWOOD & TRELMA L. PRESTWOOD  
NEAR GREENVILLE, GREENVILLE COUNTY, S.C.


21 OCT 1983

20116 ✓

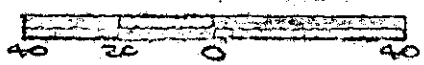

10-G-36 DEC 29 1983

I Certify That The Ratio Of Precision Of The Field Survey  
Is 1/7500 As Shown Hereon And That The Area  
Determined By D.M.D. Method Of Area Calculations

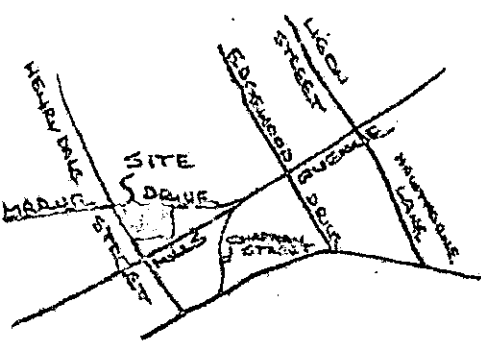

LOCATION MAP  
NO SCALE

Recordable Plat

*R. A. Brantly*  
R.L.S. 1982

CAROLINA SURVEYING CO.  
113 MAR 21 DE 29 83 388  
GREENVILLE, S.C.

3.000CI