


28  
GREENVILLE CO. S. C. 27

1/4 23 25 00 04 N 75 - 32 E 150.45


DONNIE S. TANKERSLEY  
R.M.C.

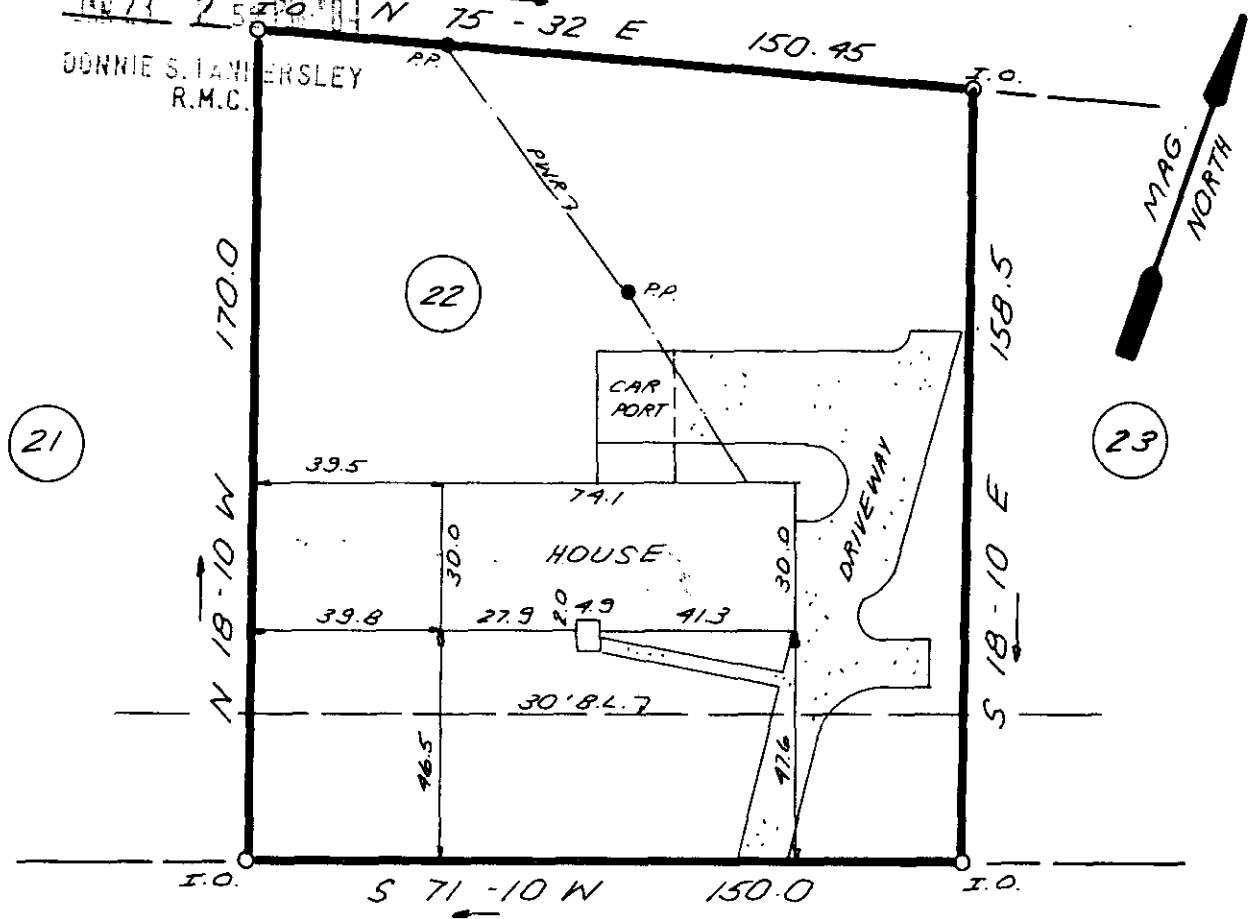


JAN 23 1984

WEEHAWKEN CIRCLE

18-G-108  
22799 ✓

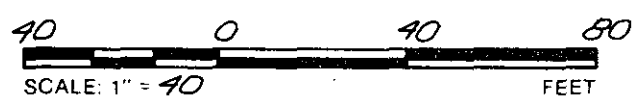

THIS IS TO CERTIFY THAT THE PROPERTY SHOWN ON THIS PLAT WAS SURVEYED UNDER MY DIRECT SUPERVISION. PROPERTY LINES AND IMPROVEMENTS SHOWN ARE LOCATED CORRECTLY AND THAT NO VISIBLE ENCROACHMENTS EXIST UNLESS OTHERWISE SHOWN. THIS PROPERTY IS NOT LOCATED IN A DESIGNATED FLOOD HAZARD AREA.

|   |   |  |
|---|---|--|
| <br>W. B. HUNTLEY III<br>RLS: W. B. HUNTLEY III<br>NO: 8809 | STATE OF SOUTH CAROLINA<br>GREENVILLE COUNTY                    | FREELAND & ASSOCIATES<br>Engineers • Land Surveyors<br>318 WEST STONE AVENUE,<br>GREENVILLE, S. C.<br>(803) 271-4924   |
|   | WEEHAWKEN HILL<br>LOT 22<br>PROPERTY OF<br>NORMA JANE ROBERTSON | PLAT BOOK 4F-50<br>DEED BOOK<br>TAX MAP P3-1-92<br>PARTY CHIEF J.C.<br>DRAWN K.E.G.<br>DATE 1-19-84<br>DWG NO. 10368-1 |